


Provide columns similar to existing photo for new press box and stairs.

SECTION VIEW @ PRESS BOX
SCALE: 3/8" = 1'-0"

Press Box and stair access will be constructed separately in phase 1 of this project.

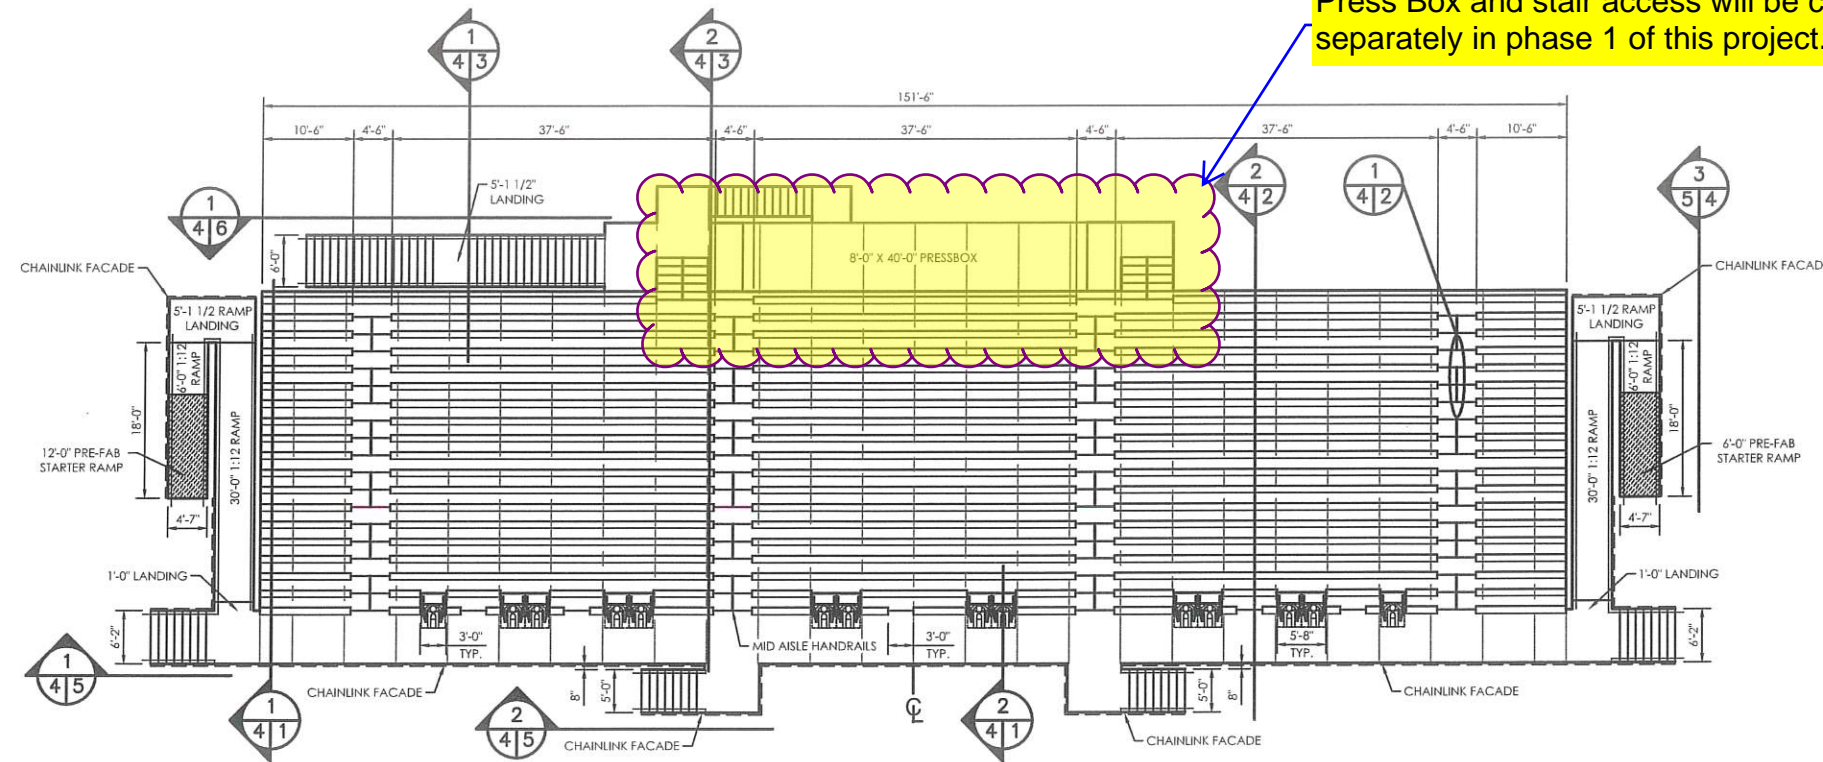


Please provide similar design for Press Box and Bleachers with similar seating capacity.

1 SEATING LAYOUT - HOME SIDE
SCALE: 1/8" = 1'-0"

1615 TOTAL NET 18" SEATS
14 TOTAL NET 33" WHEELCHAIR SPACES
1629 TOTAL SEATING CAPACITY

Bleacher design to be provided in conjunction with Press Box. Existing bleacher demolition and new bleacher construction will be completed as part of phase 2 for this project.

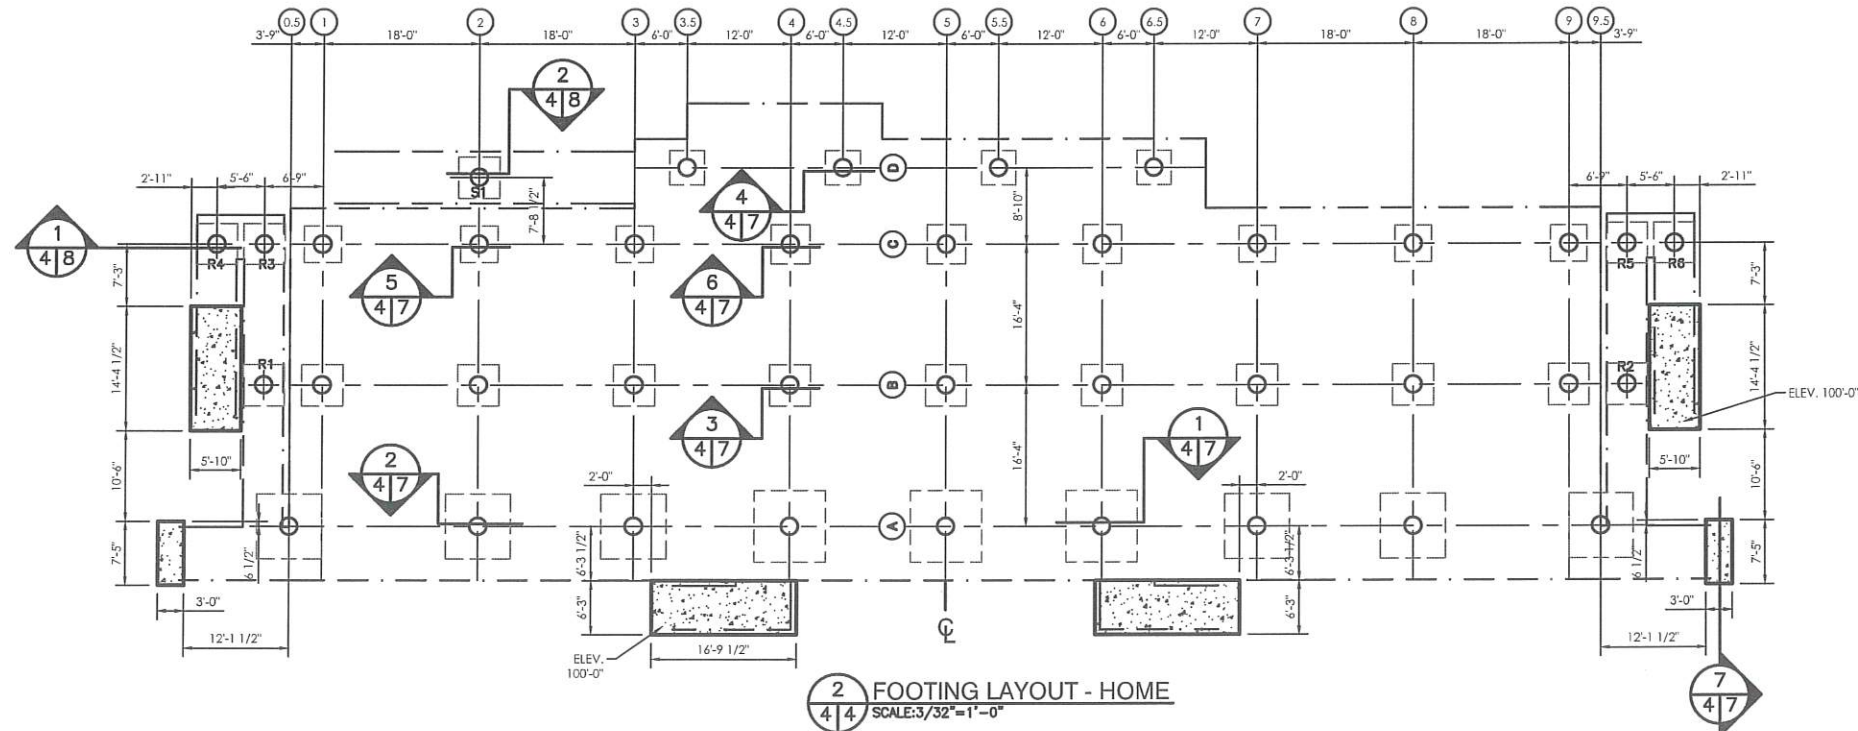

2 FOOTING LAYOUT - HOME
SCALE: 3/32" = 1'-0"

FOR REFERENCE ONLY!!