


Date of Issuance: 2.19.2025  
Project: Hyrum City – Libbie Springs Park  
Subject: Contract Document revisions & bid Questions/Responses

Incorporate the following revisions to the Specifications, Drawings and other Contract Documents of the above named project. General Items are not referenced. Revisions to the Specifications are referenced by section, page number, and paragraph number. Revisions to the Drawings are referenced by drawing sheet number. This addendum forms part of the Construction Document.

The end of the Addendum is indicated by the note "END OF ADDENDUM". Attachments are located at the end of the Addendum and are referenced in the Addendum.

- Item2.1
  - Add bid alternate concrete perimeter walk in three different locations as shown on sheet C101 & C102. Install area drain as shown on sheet C101 at existing inlet pipe location. Assumed box height should be 3'-0" from flow line. Provide solid lid on area drain.
- Item2.2
  - Add concrete hatch to bench pads & bike rack pad C102.
- Item2.3
  - Remove boulders from trail at playground all 102 sheets.
- Item2.4
  - Add Sheets D001 Demolition Plan and C002 SWPPP, see attached. Contractor shall provide SWPPP plan and all permitting required by city and state.
- Item2.5
  - Sheets C202 cut existing grade hillside to provide fill along property line edge and at existing spring outlet. Anticipate 3-4 feet fill along spring flowline area after French drain has been installed.

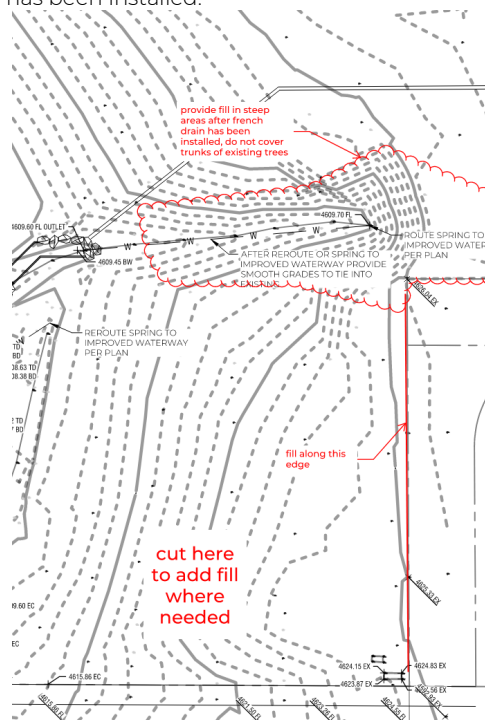

- Item2.6
  - Revise details 5, 11, and 12 as shown on attached C500


- Item 2.7
  - Change official bid date submission to February 25, 2025 due at 5:00 PM MST

QUESTIONS & RESPONSES

1. Plan states that the amount of boulders is not called out in the legend and to look at the plans. I did that, but did not see any called out on the plans. They show them in the colored pictures, but it is not clear enough to be able to count them. Any help would be appreciated.  
Response: Boulder wall is on the west side of the pickleball court. See layout and grading plan for location.
2. Are there any other items that need to be submitted with the cost proposal? Contractor qualifications, project schedule, etc.  
Response: Yes, please submit info as requested in RFP section 3: proposal and pricing.
3. Does the playground curbing need to step at each EC elevation or will it slope to match the EC elevations called out?  
Response: Playground curbing is intended to have a consistent slope with some of the concrete exposed where steps occur. See concept below.



4. Please clarify the perimeter sidewalks that should be included in the bid alternate.  
Response: See addendum #2 for info and attached sheets C101 & C102. Match grades of adjacent road with a 2% slope away. City will do work in parkstrip. Provide two 4" sleeves in each section of walk for owner to tie irrigation into parkstrip.
5. Should the clearing and grubbing be included in the earthwork bid item?  
Response: Clearing and grubbing may be included in earthwork bid item. Bid schedule is generic and should include all items in documents.
6. Please clarify which areas need to be included in the fine grading bid item.  
Response: Bid schedule is generic and should include all items in documents. Fine grading may include the work you see fitting.
7. Will the contractor be responsible for the furnish and install of subgrade materials under the 4" untreated base course at the pickleball court? If so, is it acceptable to grade and compact native?  
Response: Yes, contractor will be responsible for the base course and earthwork under the 4" compacted base course. Detail below shows work to be done by others. Coordinate with city and provide staking.

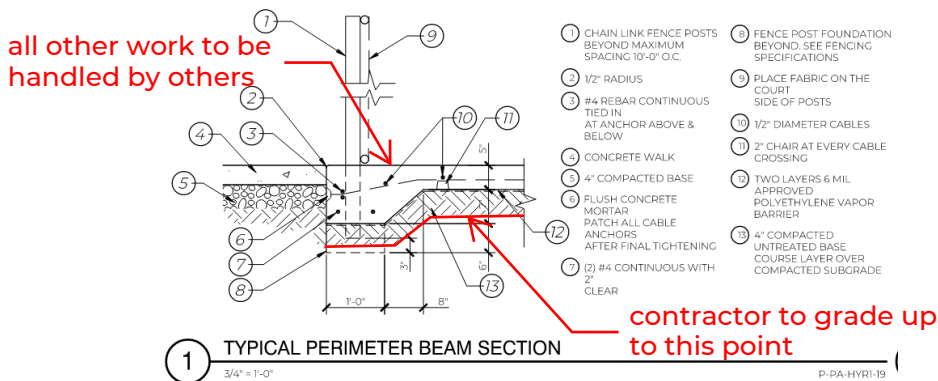

8. There aren't any bid items specific to the pavilion and shade structure. Will those be added to the bid schedule?  
Response: Majority of work is concrete work. Lump price in where makes most sense as bid form is generic and not detailed.
9. The ADA ramp with handrail is somewhat unclear. The plan shows what could be a curb on either side of the ramp (similar to 3/C501), but the detail shows steel at the lower part of the handrail. The detail does not show a rail at the midpoint of the handrail. The detail also shows a column footing for the handrail posts. Is there an option that we can use to allow for surface mounting the handrail or core drilling and grouting?  
Response: Revise layout plan to remove the raised curb. See new detail 5/C500 and revised detail 12/C500.
10. Would it be acceptable to use #3 rebar @ 18"-24" O.C.E.W. in lieu of the WWF called out at the basketball court?  
Response: Yes a substitute for basketball court #2 callout may be #3 rebar @ 18" O.C.E.W
11. C101 Note 13. Calls for basketball court. L101 Show Post Tension court provided by owner. Is this owner or contractor provided. If contractor, do you want post tension or just follow detail 7 on C500?  
Response: Remove post tension note on sheet L101. Yes, follow detail #7/C500 as called out on C101.
12. Bridge, any rails or just the bridge? Is a question Links bridge is asking.  
Response: Bridge does not need railing because fall height is less than 30", just needs to have the side guiderail lip to prevent wheelchair from falling off.
13. It's hard to put a number to maintenance without knowing some more specifics on the native grass area, can you provide some additional parameters?  
Response: For the maintenance of the native grass area please provide a total of seven visits this year to provide spot spray weed control, provide approximately 15,000 sq ft of additional overseeding of the native grass cabin mix to be spread over a time period of three different visits.
14. How do we bid the rock as noted in the plant schedule without knowing specifics?  
Response: Please provide the owner with two different color options of gravel. As long as the size and type requirement is met per plant schedule, gravel rock will be accepted.
15. Can you provide more specifics on the boulder wall on the west side of the pickleball courts?  
Response: Rock wall is intended to be exposed 2'-0" to 2'-6" in height to provide space for trees and for pickleball court to be elevated.

END OF ADDENDUM




 02.19.2025

ISSUED BY  
Landscape Architect

Date


ACCEPTED BY  
Contractor

Date

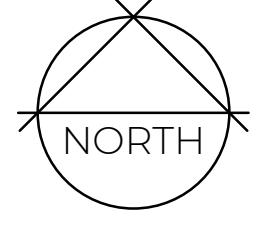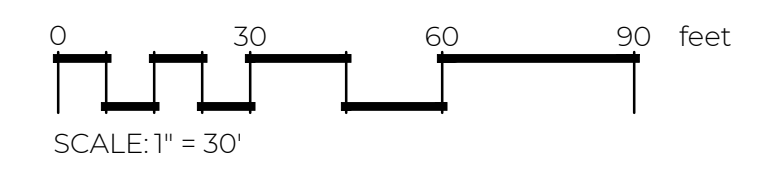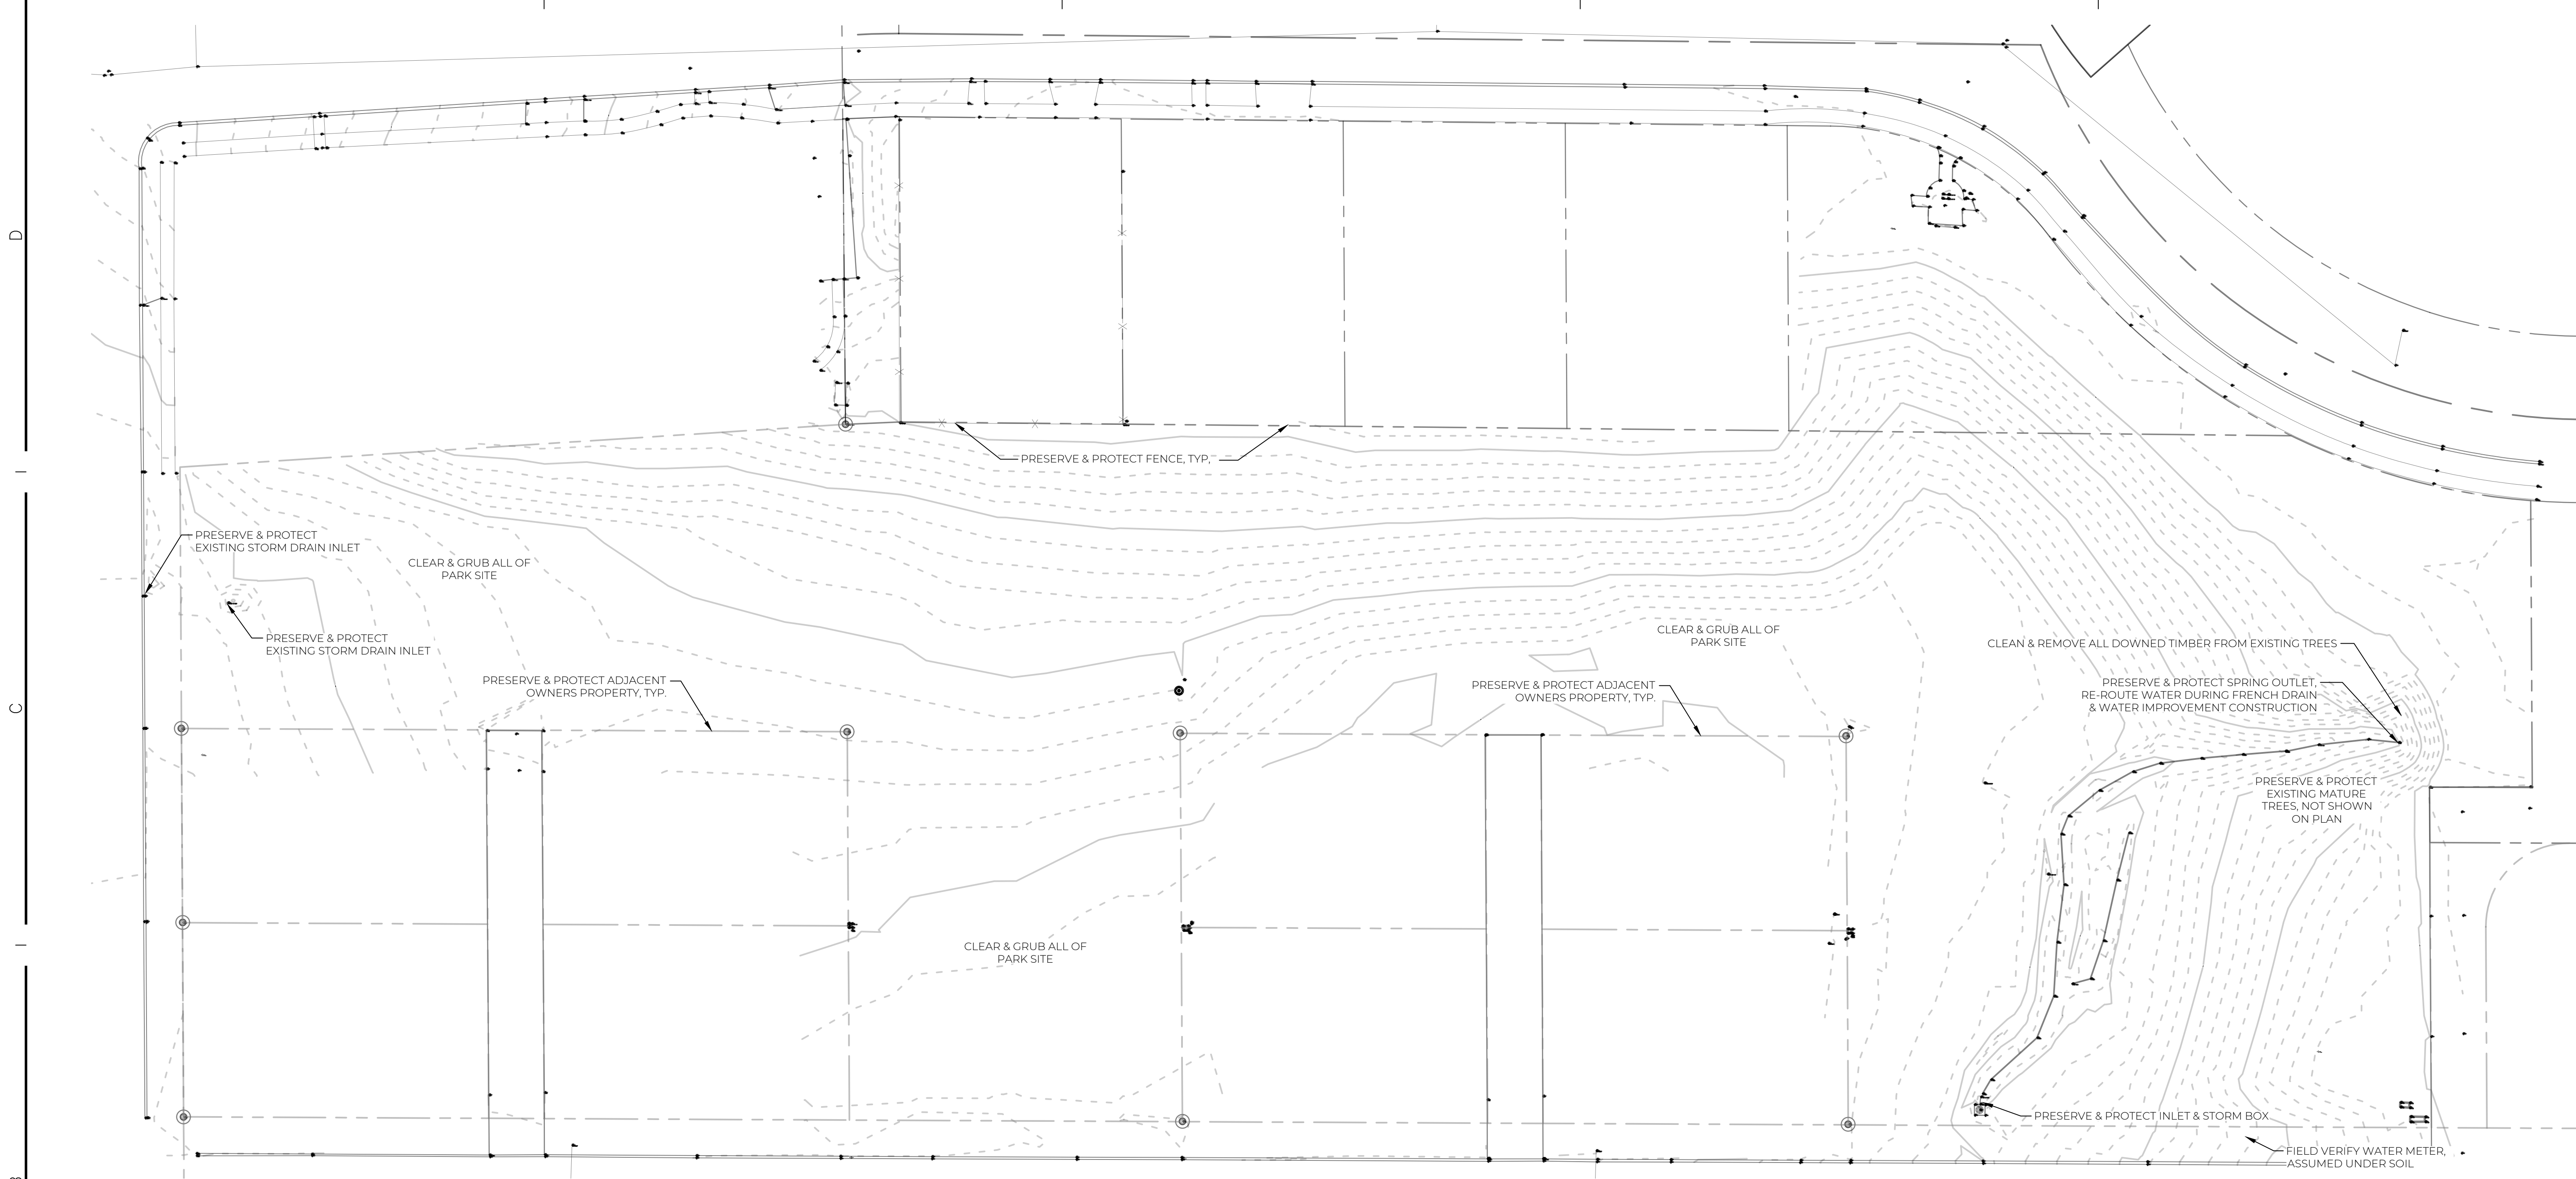

**DEMOLITION NOTES**

1. PRIOR TO THE COMMENCEMENT OF ANY WORK, THE CONTRACTOR SHALL VERIFY THE LOCATION OF ALL UNDERGROUND UTILITIES. THE CONTRACTOR SHALL PROTECT THOSE UTILITIES THAT ARE TO REMAIN AND BE RESPONSIBLE FOR THE REPAIR OF DAMAGES TO SUCH UTILITIES.
2. REMOVE OBSTRUCTIONS, TREES, SHRUBS, GRASS, AND OTHER VEGETATION TO PERMIT INSTALLATION OF NEW CONSTRUCTION.
3. CUT MINOR ROOTS AND BRANCHES OF TREES INDICATED TO REMAIN IN A CLEAN AND CAREFUL MANNER WHERE SUCH ROOTS AND BRANCHES OBSTRUCT INSTALLATION OF NEW CONSTRUCTION.
4. GRIND STUMPS AND REMOVE ROOTS, OBSTRUCTIONS, AND DEBRIS EXTENDING TO A DEPTH OF 18 INCHES BELOW EXPOSED SUBGRADE.
5. FILL DEPRESSIONS CAUSED BY CLEARING AND GRUBBING OPERATIONS WITH SATISFACTORY SOIL MATERIALS IN HORIZONTAL LAYERS NOT EXCEEDING 8" INCH LOOSE DEPTH, AND COMPACT EACH LAYER TO A DENSITY EQUAL TO ADJACENT GROUND.
6. STRIP SUITABLE TOPSOIL TO WHATEVER DEPTHS ARE ENCOUNTERED IN A MANNER TO PREVENT INTERMINGLING WITH UNDERLYING SUBSOIL OR OTHER WASTE MATERIALS.
7. STOCKPILE SURPLUS TOPSOIL MATERIALS AWAY FROM EDGE OF EXCAVATIONS WITHOUT INTERMIXING WITH SUBSOIL. GRADE AND SHAPE STOCKPILES TO DRAIN SURFACE WATER. COVER TO PREVENT WINDBLOWN DUST. COORDINATE LOCATION WITH OWNERS REPRESENTATIVE OR AT LOCATION SHOWN ON PLANS.
8. REMOVE EXISTING ABOVE- AND BELOW-GRADE STRUCTURES AS INDICATED AND AS NECESSARY TO FACILITATE NEW CONSTRUCTIONS.
9. AT ALL LOCATIONS WHERE EXISTING PAVEMENT ABUTS NEW CONSTRUCTION, THE EDGE OF THE EXISTING PAVEMENT SHALL BE SAW CUT TO A CLEAN SMOOTH EDGE.
10. PROTECT EXISTING WALKS, DRIVES, CURBS, EXISTING VEGETATION, ETC. THAT ARE TO REMAIN. REPAIR ANY DAMAGES THAT MAY OCCUR TO EXISTING ITEMS TO BE PROTECTED.
11. ALL ITEMS TO BE REMOVED FROM THE PROJECT AND EXCESS MATERIALS SHALL BE LEGALLY DISPOSED OF OFFSITE BY THE CONTRACTOR.
12. CONTINUOUSLY CLEAN-UP AND REMOVE WASTE MATERIALS FROM SITE. DO NOT ALLOW MATERIALS TO ACCUMULATE ON SITE.
13. DO NOT BURN OR BURY MATERIALS ON SITE. LEAVE SITE IN CLEAN CONDITION.
14. BLUE STAKE SITE AND OBTAIN ALL REQUIRED HYRUM CITY PERMITS.

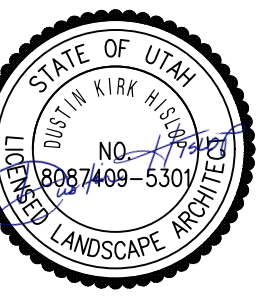

TITLE	DEMOLITION PLAN		
PROJECT	LIBBIE SPRINGS PARK		
CLIENT	HYRUM CITY		
ADDRESS	20 NORTH 680 WEST, HYRUM, UT 844319		

REVISIONS		
NO.	DATE	DESCRIPTION
ADZ	2025.02.19	ADD SHEET




DATE: 02-04-2025  
 JOB NUMBER: 80015  
 CHECKED BY: HISLOP



SHEET  
**D001**

ALL DRAWINGS, SPECIFICATIONS, DESIGNS AND IDEAS REPRESENTED HEREIN ARE AND SHALL REMAIN THE PROPERTY OF THE DESIGNER. NO PART THEREOF SHALL BE COPIED AND/OR DISCLOSED TO OTHERS OR USED IN CONJUNCTION WITH ANY OTHER PROJECT OTHER THAN THE SPECIFIC PROJECT FOR WHICH THEY HAVE BEEN PREPARED WITHOUT THE WRITTEN CONSENT OF THE DESIGNER. WRITTEN DIMENSIONS OF THESE DRAWINGS SHALL HAVE PRECEDENCE OVER SCALED DIMENSIONS. CONTRACTORS SHALL VERIFY AND BE RESPONSIBLE FOR ALL DIMENSIONS AND CONDITIONS ON THE JOB. NOTIFY DESIGNER OF ANY VARIATIONS FROM THE DIMENSIONS AND CONDITIONS SHOWN BY THEIR DRAWINGS. COPYRIGHT © 2025 PRIME LANDSCAPE ARCHITECTURE, LLC.

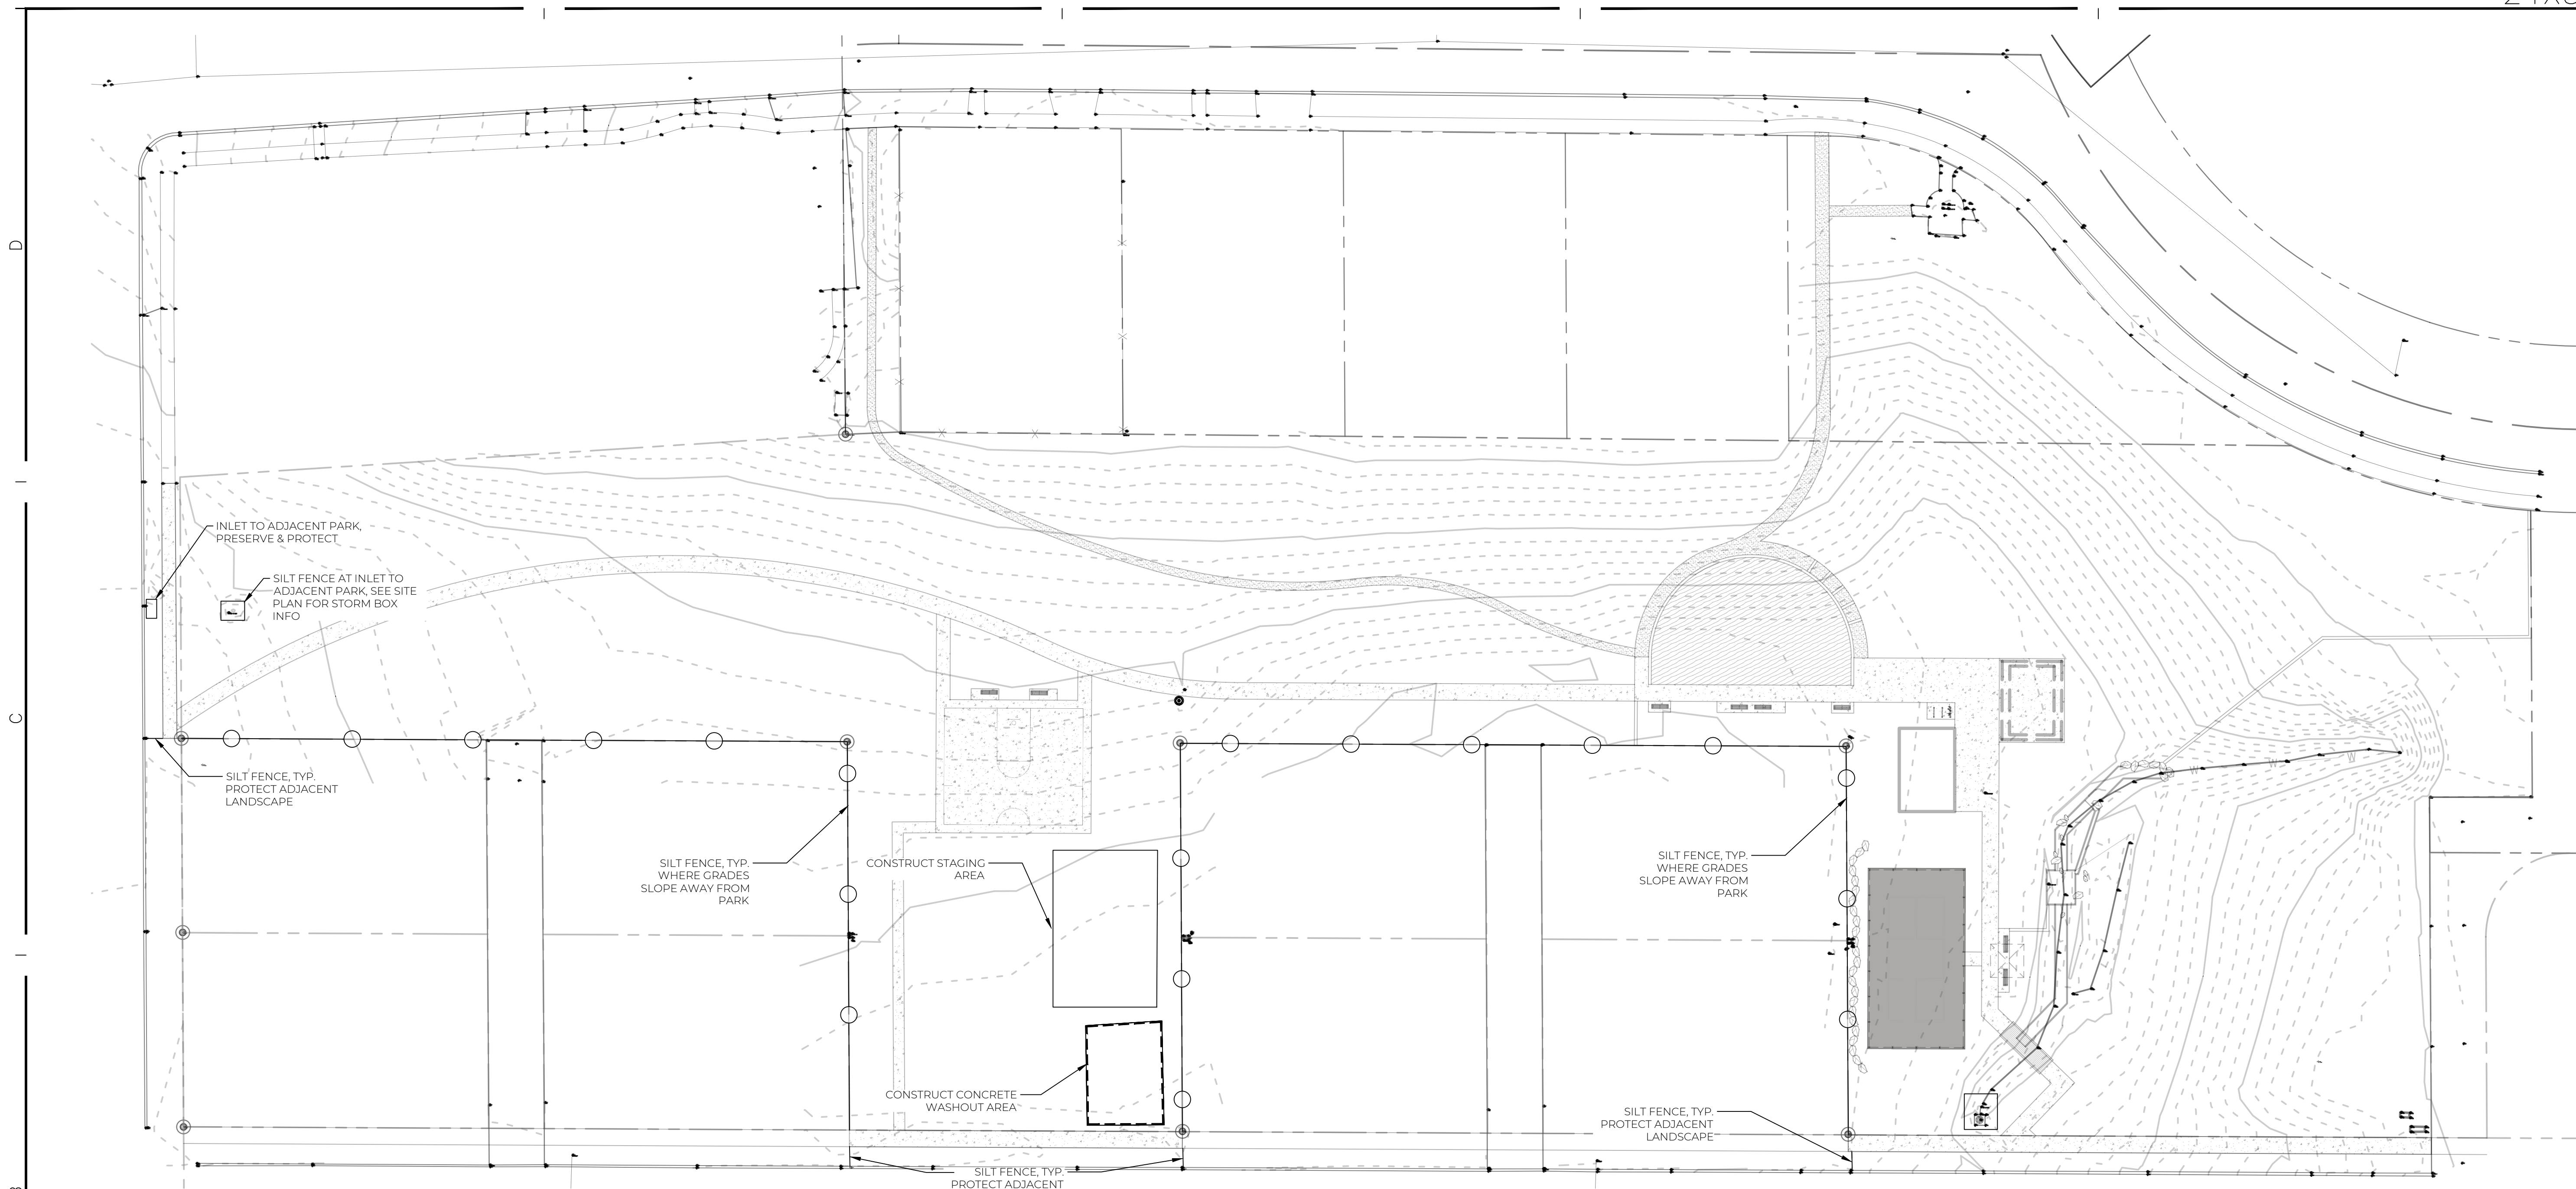

**STABILIZATION & POST-CONSTRUCTION BEST MANAGEMENT PRACTICES (BMPs)**

1. THE SITE SHALL BE STABILIZED ONCE FINAL GRADE HAS BEEN ACHIEVED AND LANDSCAPING HAS BEEN INSTALLED.
2. ONCE CONSTRUCTION IS COMPLETE, THE STORM DRAIN AND STORMWATER DETENTION SYSTEM SHALL BE STABILIZED, INSPECTED, AND MAINTAINED.
3. MAINTENANCE SHALL INCLUDE THE REMOVAL OF DEPOSITED SEDIMENT AS NECESSARY, ENSURING NO OBSTRUCTIONS OCCUR WHICH MAY IMPEDE DESIRED FLOWS.
4. INSPECTIONS SHALL TAKE PLACE AS DEFINED IN THE SWPPP OR FOLLOWING STORM EVENTS. REFER TO HYRUM CITY STORMWATER MANAGEMENT BMP & SWPPP FOR ADDITIONAL POST-CONSTRUCTION STORMWATER BMP MAINTENANCE INSTRUCTIONS.

**GENERAL NOTES**

1. THE EROSION CONTROL PLAN IS DIAGRAMATIC AND IS INTENDED TO BE VIEWED AS A GUIDELINE FOR LOCATING AND IMPLEMENTING EROSION CONTROL BEST MANAGEMENT PRACTICES (BMPs). IT IS THE CONTRACTOR'S RESPONSIBILITY TO FINALIZE THE TYPE AND LOCATION OF ALL BMPs IN ORDER TO MEET THE REGULATIONS OF THE STATE OF UTAH AND CITY. CONTRACTOR TO IMPLEMENT CONSTRUCTION SEQUENCE IDENTIFIED IN THE CITY STORMWATER POLLUTION PREVENTION PLAN REQUIREMENTS.
2. LIMITS OF DISTURBANCE: THE LIMITS OF DISTURBANCE LINE SHOWN ON THE DRAWING IS FOR MAJOR DEMOLITION AND EXCAVATION OF CIVIL RELATED ELEMENTS. IT IS ANTICIPATED THAT THERE MAY BE SOME ADDITIONAL DISTURBANCE OUTSIDE OF THESE LIMITS, PRIMARILY RELATED TO IRRIGATION/REVEGETATION IMPROVEMENT. THE CONTRACTOR IS RESPONSIBLE FOR ENSURING EROSION CONTROL BMPs ARE IMPLEMENTED FOR ALL EARTH DISTURBING ACTIVITIES, AND THAT DISCHARGE OF SEDIMENT LADEN RUN-OFF IS NOT PERMITTED.
3. STREET CLEANING: IF SEDIMENT IS TRANSPORTED ON TO THE STREET AND/OR EXISTING PARKING AREAS IT SHALL BE REMOVED ON A DAILY BASIS. SEDIMENT SHOULD BE SHOVELLED AND/OR SWEEPED FROM THE ASPHALT OR CONCRETE SURFACE AND DISPOSED OF IN A MANNER, WHICH PREVENTS CONTAMINATION WITH STORMWATER OR SURFACE WATER. IN ADDITION, A STREET SWEEPER MAY BE USED TO MAINTAIN CLEAN HARDSCAPE AREAS ON AN AS-NEEDED BASIS. ALL ADJACENT PARKING LOT AREAS TO THE SITE SHALL ALSO BE SWEEPED DURING WORK DAYS AND AT OTHER TIME AS NEEDED IN ORDER TO KEEP THE TRAVELED WAY CLEAN FROM MUD, DUST, SILT, AND DEBRIS.
4. VEHICLE WASH-DOWN: THE STABILIZED CONSTRUCTION ACCESS MAY BE CONSTRUCTED TO SERVE AS A TEMPORARY TRUCK WASH STATION TO ENSURE CONTROL OF SEDIMENT AT THE CONSTRUCTION EXIT POINT OR A SEPARATE WASH-DOWN AREA SHALL BE PROVIDED. THE WASH-DOWN SYSTEM CONSISTS OF A COBBLE PAD (STABILIZED AREA) LINED BELOW WITH FILTER FABRIC, GRADED TO DRAIN AND CONNECT TO THE ADJACENT DRAINAGE SWALE AND CONVEY WATER TO A TEMPORARY SEDIMENTATION BASIN TO COLLECT WASH WATER FOR SETTLEMENT OF DEBRIS. WASH WATER MAY BE RE-USED AFTER SETTLING, INFILTRATED ON SITE, OR TRANSPORTED OFF SITE FOR DISPOSAL. ACCUMULATED SEDIMENTS MAY BE REUSED ON SITE OR DISPOSED OF OFF SITE.
5. CONCRETE CLEANOUT BASIN: A DUMPSTER OR LINED BASIN SHALL BE PLACED NEAR THE ENTRANCE/EXIT TO THE SITE AND ALL CONCRETE DELIVERY VEHICLES SHALL BE REQUIRED TO WASH OUT ONLY INTO THE DUMPSTER/BASIN. CONTRACTOR SHALL REMOVE WASTER AND DISPOSE OF IN A LAWFUL MANNER AS NECESSARY. CONCRETE WASH OUT MAY NOT BE DISPOSED OF ON-SITE OR ALLOWED TO INFILTRATE.
6. DUST CONTROL: SOILS, GRAVELS, AND ETC., WHETHER STOCKPILED OR PLACED, SHALL BE KEPT COVERED AND/OR ADEQUATELY MOIST TO PREVENT AIRBORNE DUST FROM LEAVING THE SITE. ALL CONSTRUCTION AREAS AND EXISTING PAVED AREAS SHALL BE KEPT ADEQUATELY MOIST TO PREVENT AIRBORNE DUST FROM LEAVING THE SITE.
7. DRAIN INLET PROTECTION: ALL EXISTING STORM DRAIN INLETS WITHIN THE PROJECT AREA OR WHICH MAY RECEIVE RUNOFF FROM THE PROJECT AREA SHALL BE PROTECTED ON-SITE. INLET PROTECTION TO BE INSTALLED AND APPROVED/INSPECTED PRIOR TO ANY EARTH DISTURBING ACTIVITIES. ALL STORM DRAINS, SUMPS, AND STORM DRAIN PIPES THAT ARE INSTALLED OR MADE OPERABLE DURING CONSTRUCTION SHALL BE PROTECTED TO PREVENT STORM WATER FROM ENTERING WITHOUT FIRST BEING FILTERED OR TREATED TO REMOVE SEDIMENT. METHOD OF PROTECTION SHALL BE AS SHOWN OR APPROPRIATE TO NEED.
8. SILT FENCING: SILT FENCING SHALL BE INSTALLED ALONG GRADING LIMIT LINE AS SHOWN ON PLAN AND ALL OTHER LOW AREAS ALONG THE LIMIT OF DISTURBANCE LINE. IT IS THE CONTRACTOR'S RESPONSIBILITY TO WALK THE PERIMETER OF THE CONSTRUCTION SITE AND TO DETERMINE ALL APPROPRIATE LOCATIONS FOR SILT FENCING TO PREVENT SEDIMENT LADEN DISCHARGE FROM LEAVING THE SITE. SILT FENCING MAY BE COORDINATED AND INSTALLED IN CONJUNCTION WITH OTHER BMPs TO PREVENT RUNOFF FROM LEAVING THE SITE DURING CONSTRUCTION.
9. TEMPORARY SWALE: A TEMPORARY SWALE MAY BE INSTALLED PROVIDING CONVEYANCE FROM THE CONSTRUCTION WASH-DOWN AREA TO A TEMPORARY SEDIMENTATION BASIN LOCATED ON-SITE. THE SWALE SHALL BE SIZED AS NECESSARY TO MEET THE NEED, BUT SHALL NOT EXCEED 4' WIDE AND 6" DEEP. THE SWALE SHALL BE INSTALLED IN CONJUNCTION WITH THE OTHER SELECTED BMPs TO ENSURE NO UNFILTERED RUNOFF IS NOT CONTAINED AND IS LIKELY TO CONTAIN SEDIMENT.
10. TEMPORARY SEDIMENTATION BASIN: A TEMPORARY SEDIMENTATION BASIN MAY BE USED TO ALLOW SEDIMENT TO FALL OUT OF RUNOFF FROM STORM EVENTS AND FROM THE WASH-OUT AREA AND OTHER AREAS ON SITE WHERE RUNOFF IS NOT CONTAINED AND IS LIKELY TO CONTAIN SEDIMENT.
11. INSTALLATION SEQUENCING: INLET PROTECTION, TEMPORARY SEDIMENT BASINS, SILT FENCE, AND OTHER BMPs INTENDED TO TRAP SEDIMENT ON SITE SHALL BE INSTALLED BEFORE LAND-DISTURBING ACTIVITIES TAKE PLACE. TEMPORARY SWALES, CONVEYANCE AND STABILIZED CONSTRUCTION ACCESS AND WASH-DOWN AREAS SHOULD BE CREATED IMMEDIATELY UPON INITIAL REMOVAL OF EXISTING MATERIAL AS A PRELIMINARY STEP IN THE SITE DEMOLITION PROCESS. INLET PROTECTION MEASURES SHOULD REMAIN IN PLACE UNTIL CONSTRUCTION IS COMPLETE AND ALL FINISH GRADE MATERIALS HAVE BEEN PLACED.
12. CONTRACTOR IS RESPONSIBLE FOR STORM WATER CONSTRUCTION PERMITTING AS REQUIRED BY THE CITY, INCLUDING THE NOTICE OF INTENT AS REQUIRED FROM THE STATE OF UTAH.
13. SEE CITY DETAILS FOR MORE INFO.



TITLE	STORM WATER POLLUTION PREVENTION PLAN
PROJECT	LIBBIE SPRINGS PARK
CLIENT	HYRUM CITY
ADDRESS	20 NORTH 680 WEST, HYRUM, UT 84319

REVISIONS		
NO.	DATE	DESCRIPTION
ADD	2025.02.19	ADD SHEET


**HYRUM CITY**  
ESTABLISHED 1860

DATE: 02-04-2025  
JOB NUMBER: 80015  
CHECKED BY: HISLOP



SHEET  
**C002**

ALL DRAWINGS, SPECIFICATIONS, DESIGNS AND IDEAS REPRESENTED HEREIN ARE AND SHALL REMAIN THE PROPERTY OF THE DESIGNER. NO PART THEREOF SHALL BE COPIED AND/OR DISCLOSED TO OTHERS OR USED IN CONJUNCTION WITH ANY OTHER PROJECT OTHER THAN THE SPECIFIC PROJECT FOR WHICH THEY HAVE BEEN PREPARED WITHOUT THE WRITTEN CONSENT OF THE DESIGNER. WRITTEN DIMENSIONS OF THESE DRAWINGS SHALL HAVE PRECEDENCE OVER SCALED DIMENSIONS. CONTRACTORS SHALL VERIFY AND BE RESPONSIBLE FOR ALL DIMENSIONS AND CONDITIONS ON THE JOB. NOTIFY DESIGNER OF ANY VARIATIONS FROM THE DIMENSIONS AND CONDITIONS SHOWN BY THEIR DRAWINGS. COPYRIGHT © 2025 PRIME LANDSCAPE ARCHITECTURE, LLC.

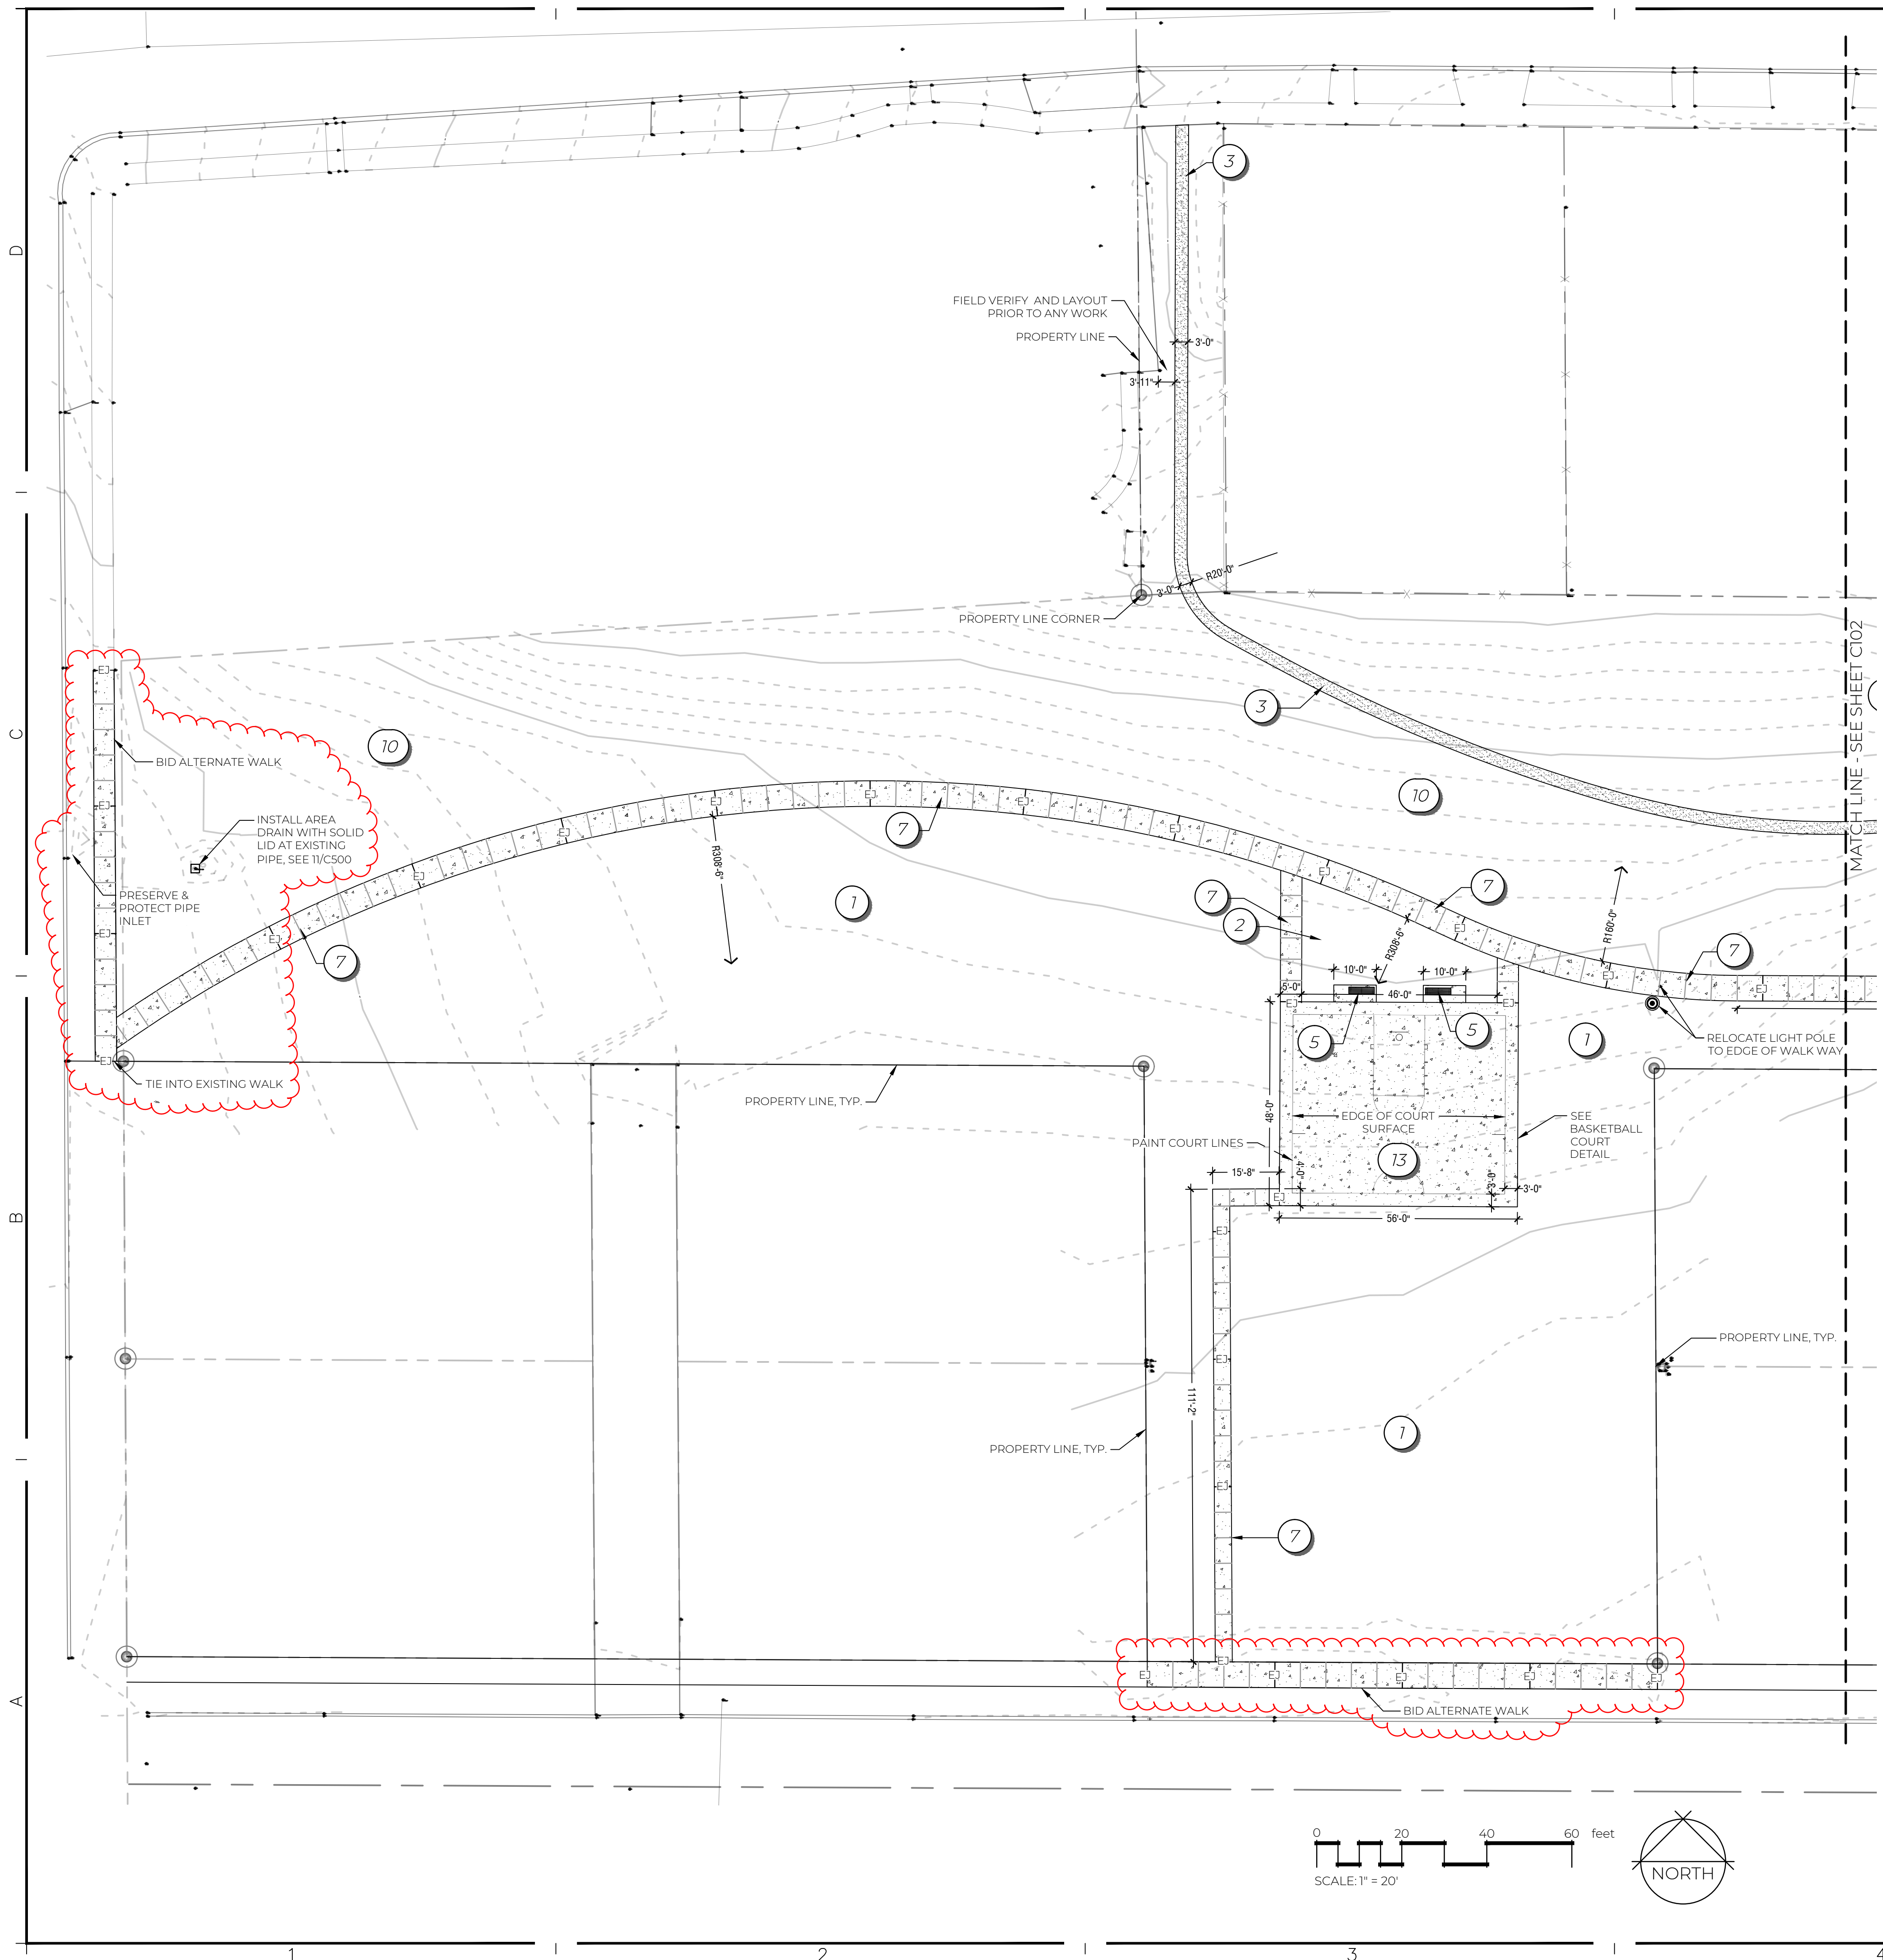


**GENERAL NOTES**

1. THE CONTRACTOR SHALL INSPECT THE SITE & FULL CONSTRUCTION DRAWING SET TO BE FULLY AWARE OF ALL PERTINENT EXISTING CONDITIONS PRIOR TO SUBMITTING BID OR PROPOSAL.
2. NO WORK IS TO BEGIN UNTIL NECESSARY PERMITS HAVE BEEN OBTAINED. IT IS THE CONTRACTOR'S RESPONSIBILITY TO OBTAIN AND PAY FOR ALL PERMITS.
3. PRIOR TO THE COMMENCEMENT OF ANY WORK, THE CONTRACTOR SHALL VERIFY THE LOCATION OF ALL UNDERGROUND UTILITIES THAT MAY BE AFFECTED BY HIS WORK. THE CONTRACTOR SHALL PROTECT THOSE UTILITIES THAT ARE TO REMAIN AND BE RESPONSIBLE FOR THE REPAIR OF DAMAGES TO SUCH UTILITIES.
4. THE CONTRACTOR SHALL NOTIFY ALL UTILITY COMPANIES WHEN CONSTRUCTION WORK BEGINS NEAR ANY UTILITY LINES AND ARRANGE FOR A UTILITY REPRESENTATIVE BE PRESENT IF THE CONTRACTOR'S CLOSE OPERATIONS COULD CREATE A HAZARDOUS CONDITION.
5. PLAN IS BASED ON OLD SURVEY AND DOES NOT HAVE RECENT CONSTRUCTION INFORMATION. CONTRACTOR TO FIELD VERIFY EVERYTHING.
6. THE CONTRACTOR SHALL PROTECT EXISTING WALKS, DRIVES, CURBS, FENCING ETC. THAT ARE TO REMAIN AND SHALL REPAIR ANY DAMAGE THAT MAY RESULT FROM CONSTRUCTION OPERATIONS.
7. THE LANDSCAPE AND IRRIGATION CONTRACTORS SHALL COORDINATE THEIR WORK WITH ANY OTHER CONTRACTORS AND TRADES WORKING ON THIS PROJECT. PROVIDE SLEEVES AS REQUIRED FOR DRAINAGE, IRRIGATION AND ELECTRICAL LINES, ETC. PRIOR TO PAVING AND LANDSCAPE WORK.
8. THE CONTRACTOR IS RESPONSIBLE FOR ANY UNAUTHORIZED DAMAGE INSIDE AND OUTSIDE THE LIMIT OF WORK LINE DUE TO CONTRACT OPERATIONS AND SHALL RESTORE DAMAGED AREAS TO ORIGINAL CONDITIONS AT NO COST TO THE OWNER.
9. CONTRACTOR SHALL BE RESPONSIBLE FOR YARD AND BUILDING CLEANUP AT THE COMPLETION OF WORK.
10. COORDINATE ALL EQUIPMENT AND MATERIAL STORAGE LOCATIONS WITH OWNER PRIOR TO MOBILIZING ON SITE.

**REFERENCE NOTES SCHEDULE**

CODE	DESCRIPTION	DETAIL
1	GRASS SOD AREA	5/L500
2	PLANTER BED	8/L500
3	TRAIL ADA APPROVED SURFACE SEE DETAILS & SPECIFICATIONS	9/C500
4	POST TENSION PICKLEBALL COURT, BY OWNER PROVIDE ALL BASE EARTHWORK AND COORDINATE INSTALLATION TIMING WITH OWNER	2/C502
5	BENCH OWNER PROVIDED, CONTRACTOR INSTALLED	
7	CONCRETE WALK	1/C500
8	ENHANCED WATER WAY SEE DETAILS	1/C501
9	BURIED 4" FRENCH DRAIN LINE TO DIRECT SPRING WATER	4/C501
10	NATIVE CABIN GRASS SEED SEE SPECIFICATIONS	
11	CONCRETE MOWSTRIP	4/C500
12	ADA RAMP	12/C500
13	CONCRETE BASKETBALL COURT	7/C500
14	SUPERIOR SHADE SQUARE CANTILEVER UMBRELLA SHADE MODEL # CU1212081G / OWNER TO SELECT COLOR INSTALL PER MANUFACTURERS RECOMMENDATIONS	

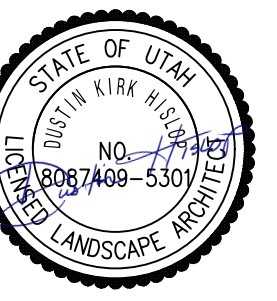

TITLE	LAYOUT PLAN
PROJECT	LIBBIE SPRINGS PARK
CLIENT	HYRUM CITY
ADDRESS	20 NORTH 680 WEST, HYRUM, UT 844319

**REVISIONS**

NO.	DATE	DESCRIPTION
AD2	2025.02.19	BID ALTERNATE & DRAINAGE




DATE: 02-04-2025  
 JOB NUMBER: 80015  
 CHECKED BY: HISLOP



BLUESTAKE

SHEET  
**C101**

ALL DRAWINGS, SPECIFICATIONS, DESIGNS AND IDEAS REPRESENTED HEREIN ARE AND SHALL REMAIN THE PROPERTY OF THE DESIGNER. NO PART THEREOF SHALL BE COPIED AND/OR DISCLOSED TO OTHERS OR USED IN CONNECTION WITH ANY OTHER PROJECT OTHER THAN THE SPECIFIC PROJECT FOR WHICH THEY HAVE BEEN PREPARED WITHOUT THE WRITTEN CONSENT OF THE DESIGNER. WRITTEN DIMENSIONS OF THESE DRAWINGS SHALL HAVE PRECEDENCE OVER SCALED DIMENSIONS. CONTRACTORS SHALL VERIFY AND BE RESPONSIBLE FOR ALL DIMENSIONS AND CONDITIONS ON THE JOB. NOTIFY DESIGNER OF ANY VARIATIONS FROM THE DIMENSIONS AND CONDITIONS SHOWN BY THEIR DRAWINGS. COPYRIGHT © 2025 PRIME LANDSCAPE ARCHITECTURE, LLC.

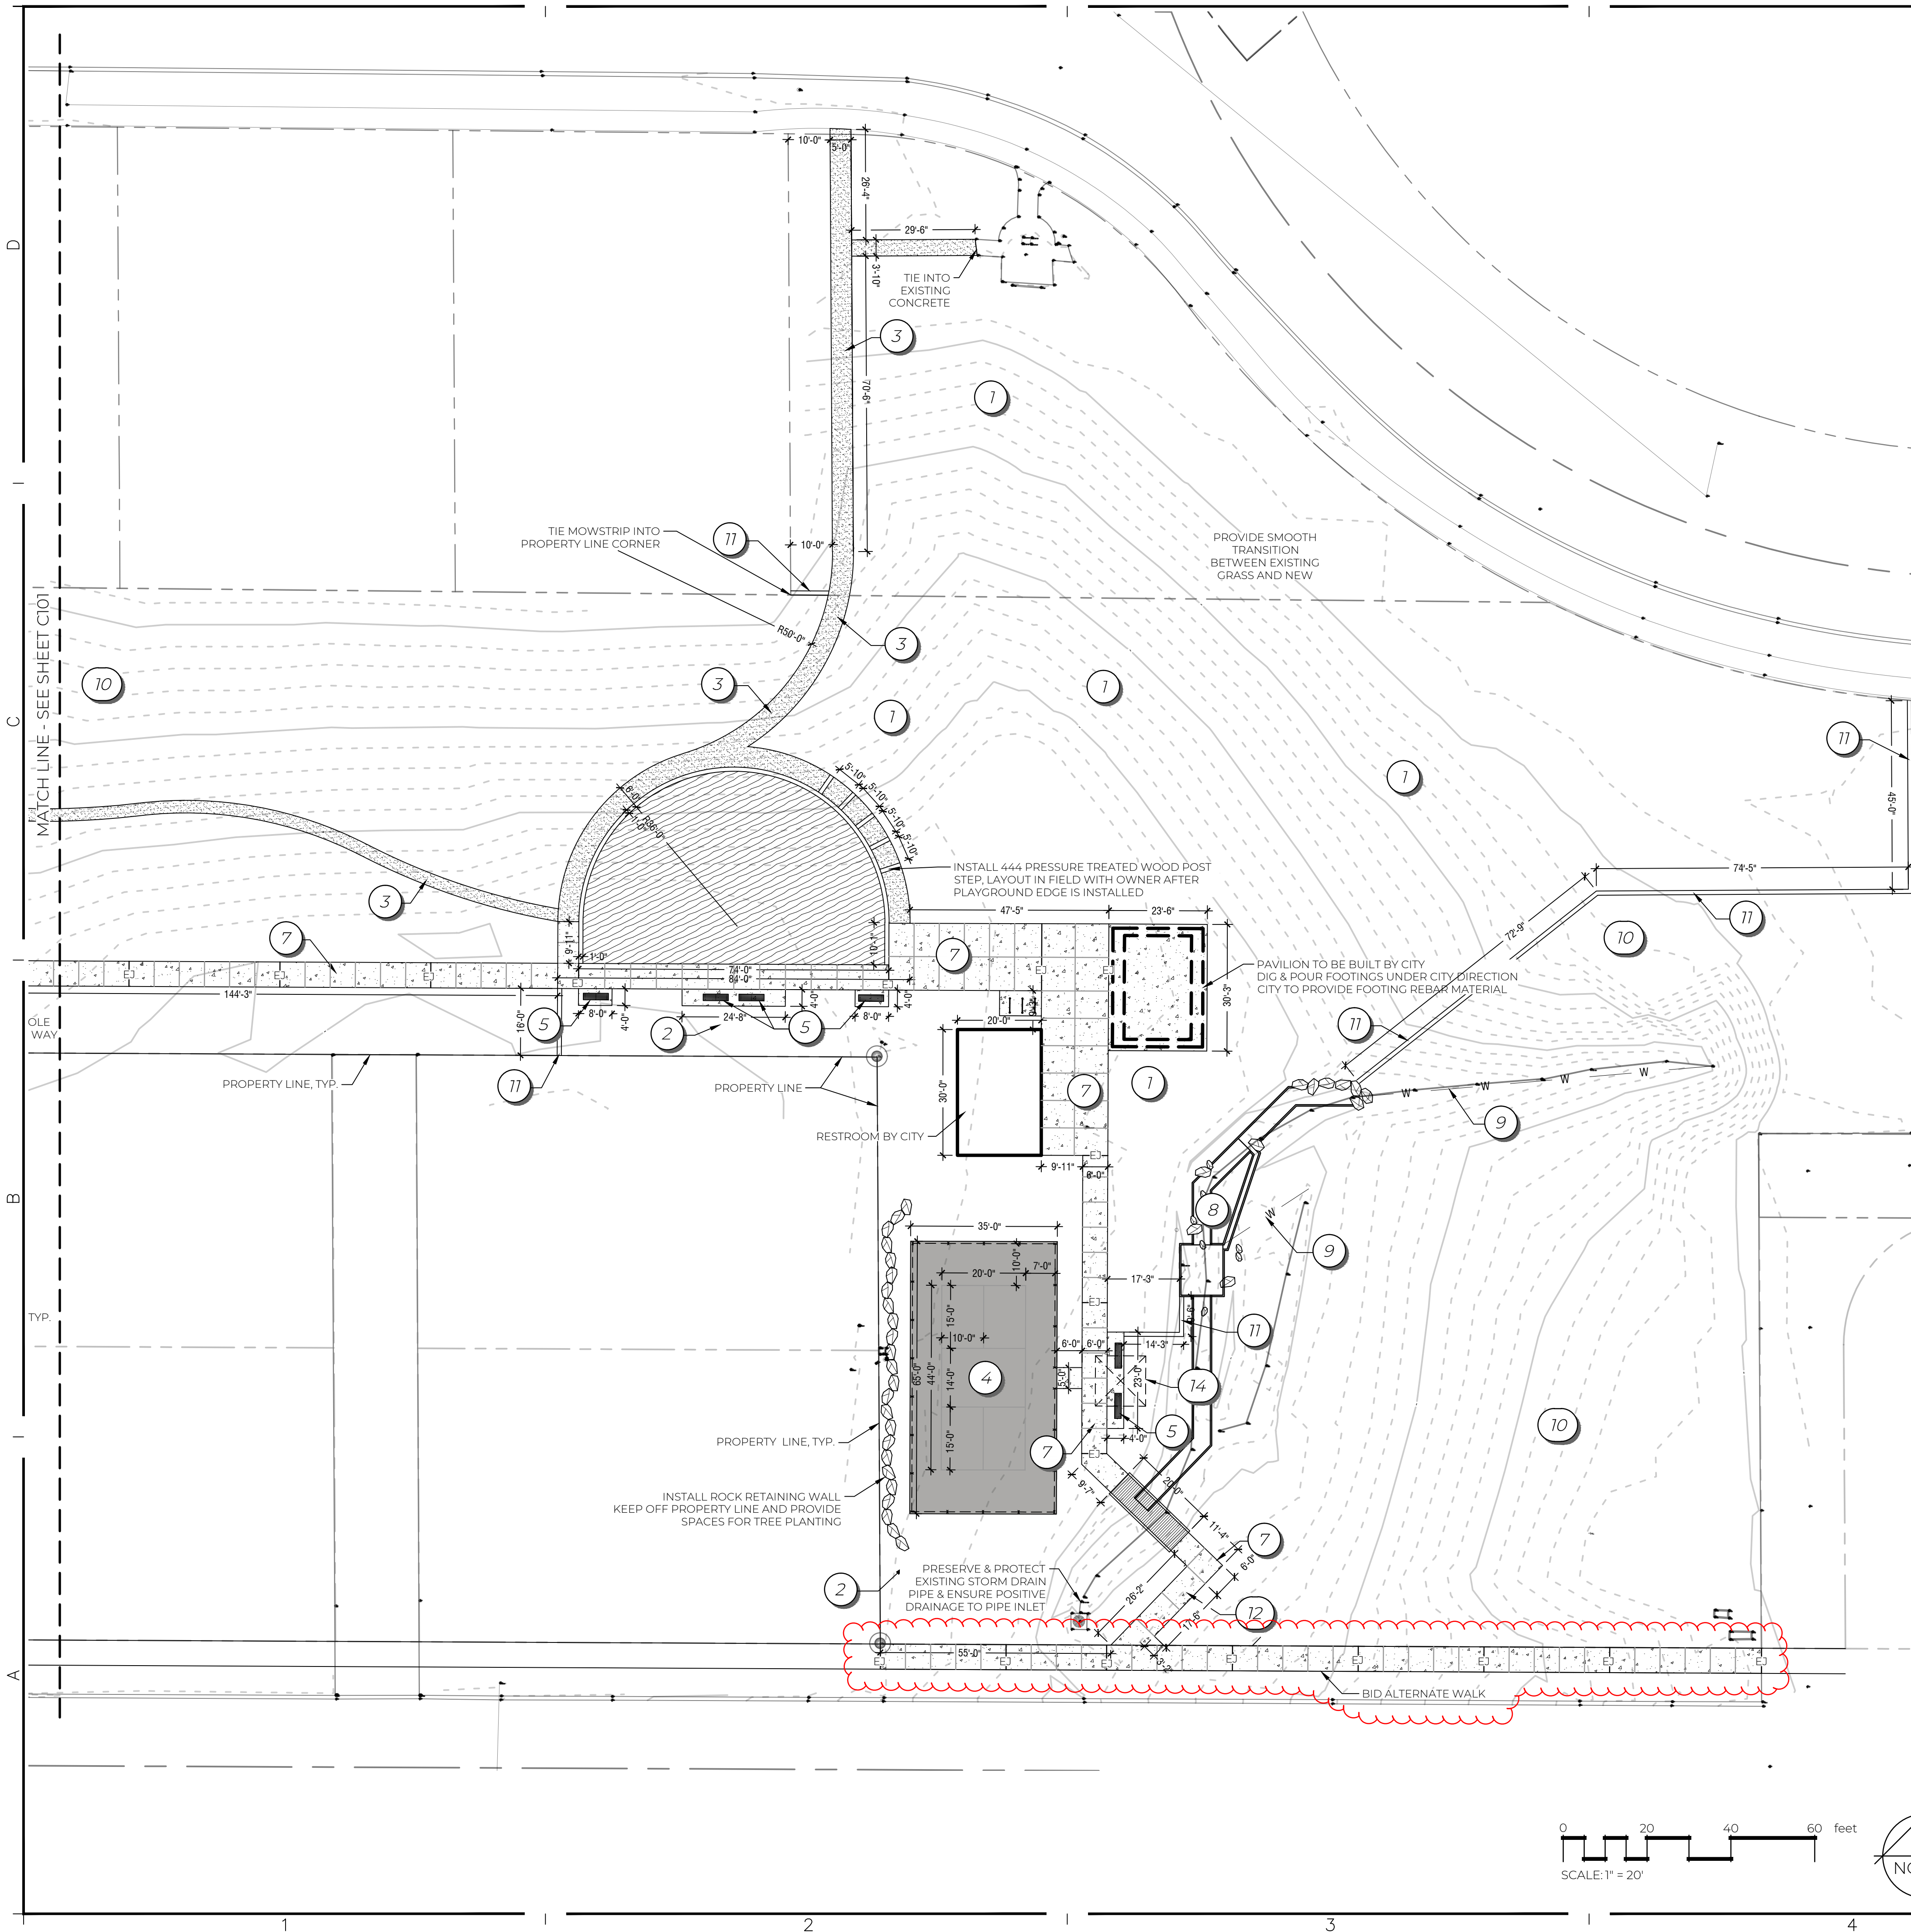

**GENERAL NOTES**

1. THE CONTRACTOR SHALL INSPECT THE SITE & FULL CONSTRUCTION DRAWING SET TO BE FULLY AWARE OF ALL PERTINENT EXISTING CONDITIONS PRIOR TO SUBMITTING BID OR PROPOSAL.
2. NO WORK IS TO BEGIN UNTIL NECESSARY PERMITS HAVE BEEN OBTAINED. IT IS THE CONTRACTOR'S RESPONSIBILITY TO OBTAIN AND PAY FOR ALL PERMITS.
3. PRIOR TO THE COMMENCEMENT OF ANY WORK, THE CONTRACTOR SHALL VERIFY THE LOCATION OF ALL UNDERGROUND UTILITIES THAT MAY BE AFFECTED BY HIS WORK. THE CONTRACTOR SHALL PROTECT THOSE UTILITIES THAT ARE TO REMAIN AND BE RESPONSIBLE FOR THE REPAIR OF DAMAGES TO SUCH UTILITIES.
4. THE CONTRACTOR SHALL NOTIFY ALL UTILITY COMPANIES WHEN CONSTRUCTION WORK BEGINS NEAR ANY UTILITY LINES AND ARRANGE FOR A UTILITY REPRESENTATIVE BE PRESENT IF THE CONTRACTOR'S CLOSE OPERATIONS COULD CREATE A HAZARDOUS CONDITION.
5. PLAN IS BASED ON OLD SURVEY AND DOES NOT HAVE RECENT CONSTRUCTION INFORMATION. CONTRACTOR TO FIELD VERIFY EVERYTHING.
6. THE CONTRACTOR SHALL PROTECT EXISTING WALKS, DRIVES, CURBS, FENCING ETC. THAT ARE TO REMAIN AND SHALL REPAIR ANY DAMAGE THAT MAY RESULT FROM CONSTRUCTION OPERATIONS.
7. THE LANDSCAPE AND IRRIGATION CONTRACTORS SHALL COORDINATE THEIR WORK WITH ANY OTHER CONTRACTORS AND TRADES WORKING ON THIS PROJECT. PROVIDE SLEEVES AS REQUIRED FOR DRAINAGE, IRRIGATION AND ELECTRICAL LINES, ETC. PRIOR TO PAVING AND LANDSCAPE WORK.
8. THE CONTRACTOR IS RESPONSIBLE FOR ANY UNAUTHORIZED DAMAGE INSIDE AND OUTSIDE THE LIMIT OF WORK LINE DUE TO CONTRACT OPERATIONS AND SHALL RESTORE DAMAGED AREAS TO ORIGINAL CONDITIONS AT NO COST TO THE OWNER.
9. CONTRACTOR SHALL BE RESPONSIBLE FOR YARD AND BUILDING CLEANUP AT THE COMPLETION OF WORK.
10. COORDINATE ALL EQUIPMENT AND MATERIAL STORAGE LOCATIONS WITH OWNER PRIOR TO MOBILIZING ON SITE.

**REFERENCE NOTES SCHEDULE**

CODE	DESCRIPTION	DETAIL
1	GRASS SOD AREA	5/L500
2	PLANTER BED	8/L500
3	TRAIL ADA APPROVED SURFACE SEE DETAILS & SPECIFICATIONS	9/C500
4	POST TENSION PICKLEBALL COURT, BY OWNER PROVIDE ALL BASE EARTHWORK AND COORDINATE INSTALLATION TIMING WITH OWNER	2/C502
5	BENCH OWNER PROVIDED, CONTRACTOR INSTALLED	
7	CONCRETE WALK	1/C500
8	ENHANCED WATER WAY SEE DETAILS	1/C501
9	BURIED 4" FRENCH DRAIN LINE TO DIRECT SPRING WATER	4/C501
10	NATIVE CABIN GRASS SEED SEE SPECIFICATIONS	
11	CONCRETE MOWSTRIP	4/C500
12	ADA RAMP	12/C500
13	CONCRETE BASKETBALL COURT	7/C500
14	SUPERIOR SHADE SQUARE CANTILEVER UMBRELLA SHADE MODEL # CU121208IC / OWNER TO SELECT COLOR INSTALL PER MANUFACTURERS RECOMENDATIONS	




TITLE	LAYOUT PLAN
PROJECT	LIBBIE SPRINGS PARK
CLIENT	HYRUM CITY
ADDRESS	20 NORTH 680 WEST, HYRUM, UT 84319

REVISIONS		
NO.	DATE	DESCRIPTION
AD2	2025.02.19	BID ALTERNATE WALK



**HYRUM CITY**  
ESTABLISHED 1860

DATE: 02-04-2025  
JOB NUMBER: 80015  
CHECKED BY: HISLOP

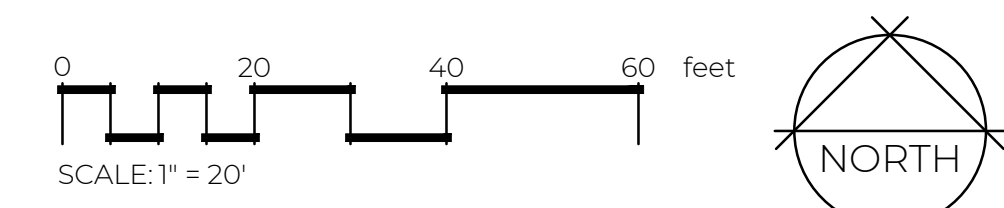


SHEET  
**C102**


ALL DRAWINGS, SPECIFICATIONS, DESIGNS AND IDEAS REPRESENTED HEREIN ARE AND SHALL REMAIN THE PROPERTY OF THE DESIGNER. NO PART THEREOF SHALL BE COPIED AND/OR DISCLOSED TO OTHERS OR USED IN CONJUNCTION WITH ANY OTHER PROJECT OTHER THAN THE SPECIFIC PROJECT FOR WHICH THEY HAVE BEEN PREPARED WITHOUT THE WRITTEN CONSENT OF THE DESIGNER. WRITTEN DIMENSIONS OF THESE DRAWINGS SHALL HAVE PRECEDENCE OVER SCALED DIMENSIONS. CONTRACTORS SHALL VERIFY AND BE RESPONSIBLE FOR ALL DIMENSIONS AND CONDITIONS ON THE JOB. NOTIFY DESIGNER OF ANY VARIATIONS FROM THE DIMENSIONS AND CONDITIONS SHOWN BY THEIR DRAWINGS. COPYRIGHT © 2025 PRIME LANDSCAPE ARCHITECTURE, LLC.

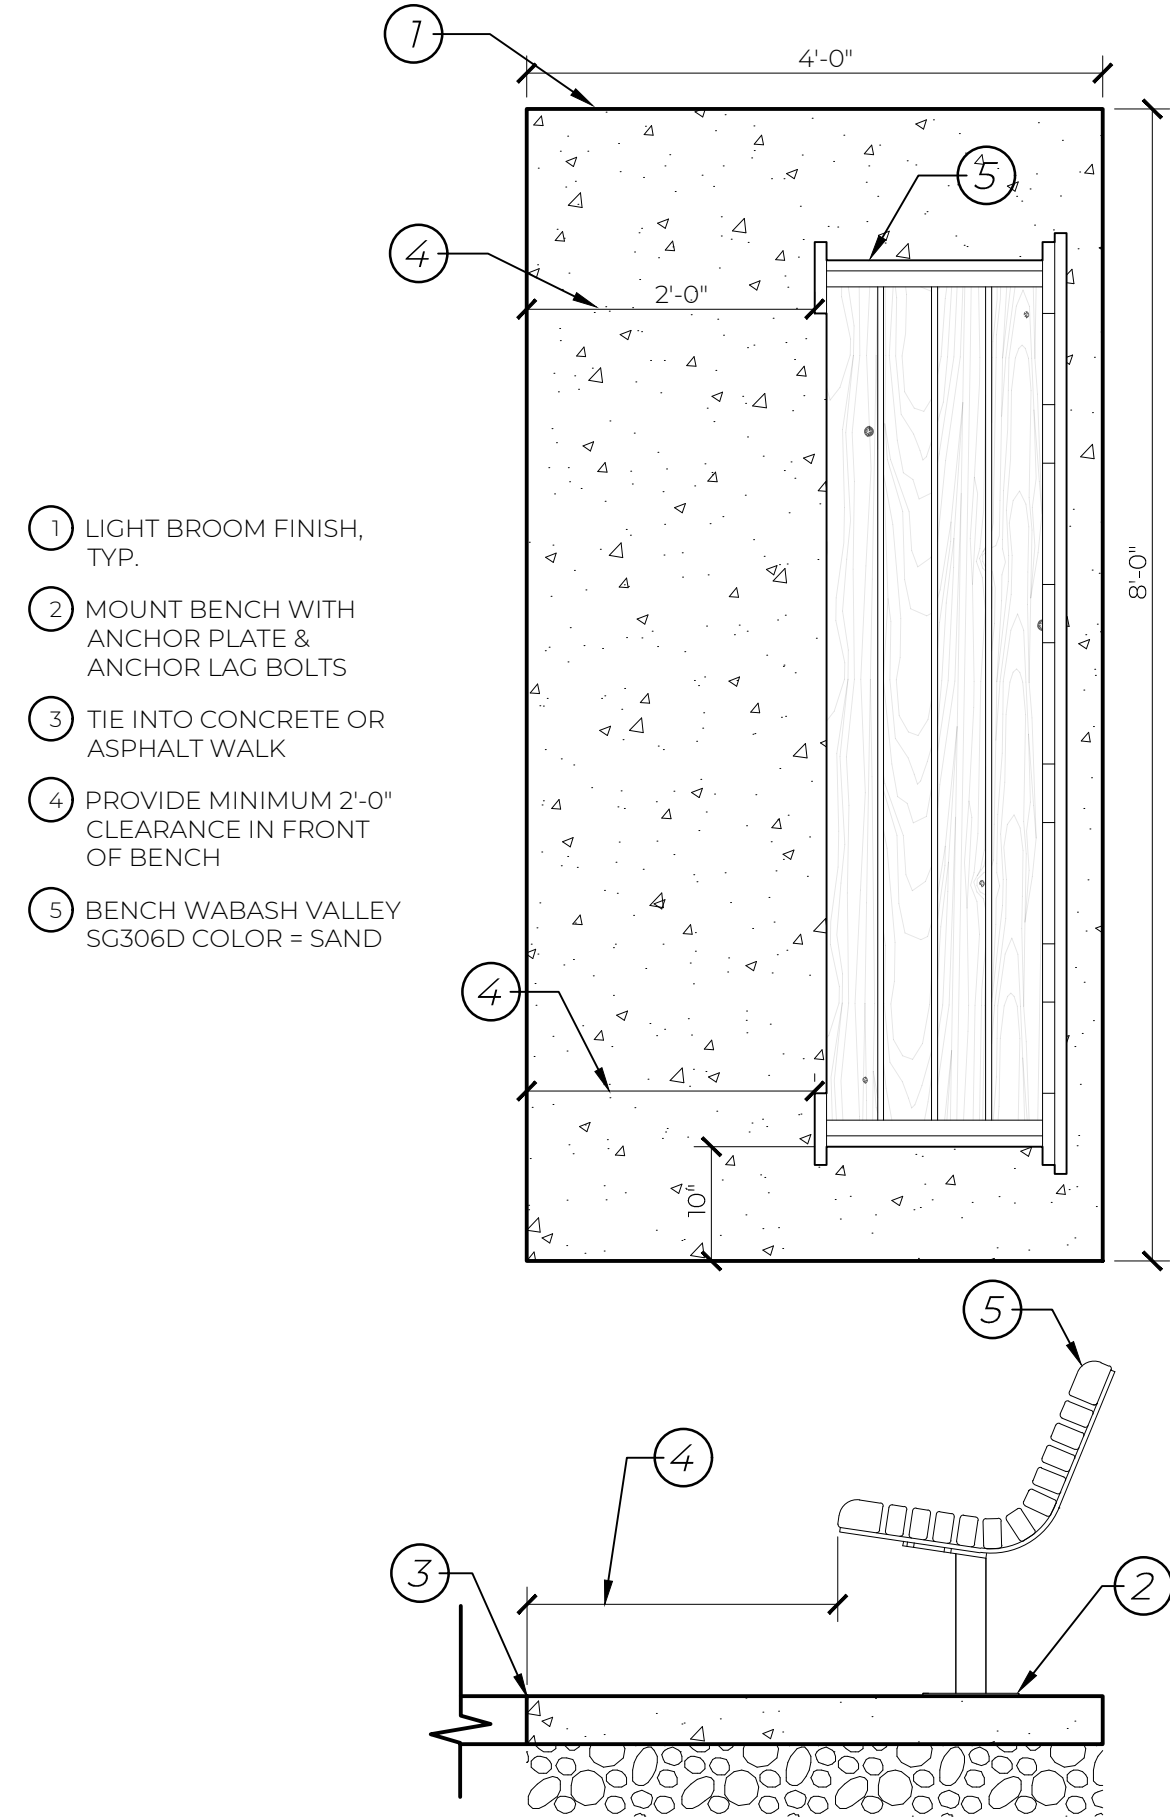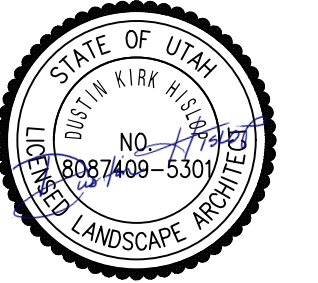


**3 CONCRETE PAD & BENCH**  
1/16" = 1'-0"  
P-PA-HYRI-04

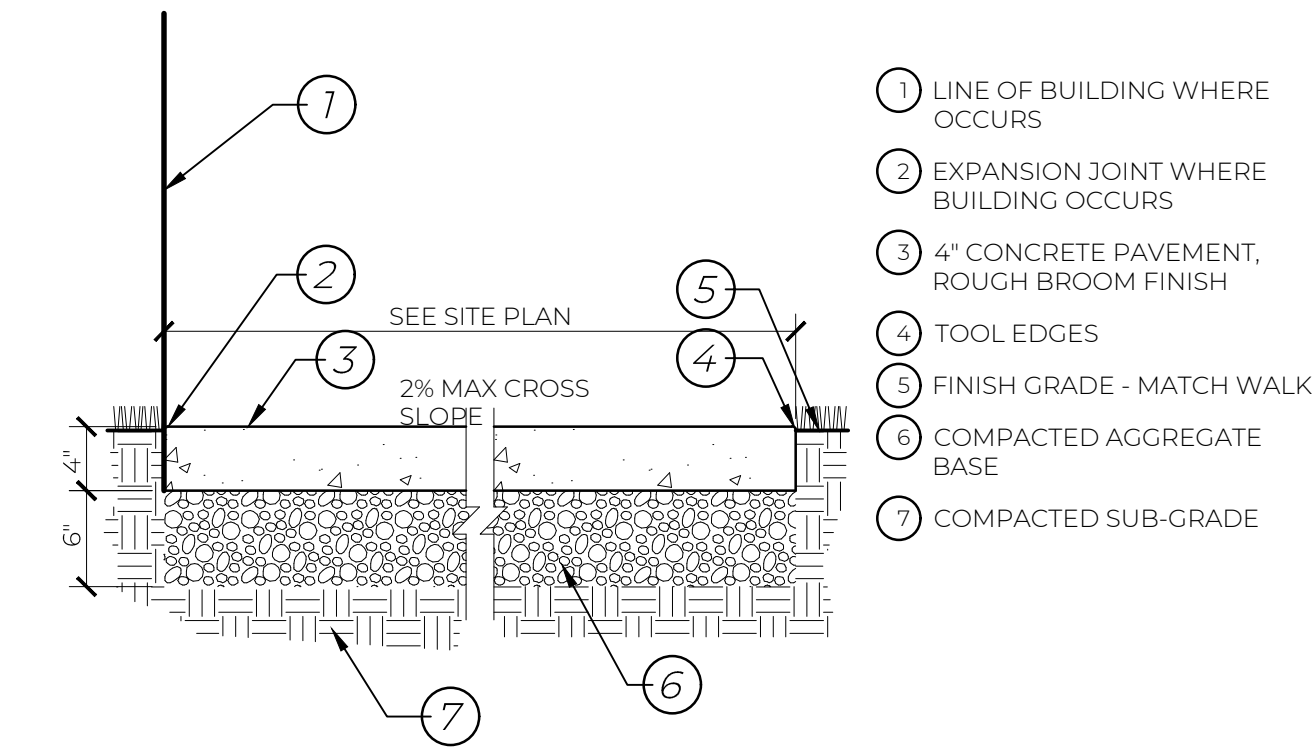


**1 CONCRETE WALK**  
1" = 1'-0"  
P-PA-HYRI-06

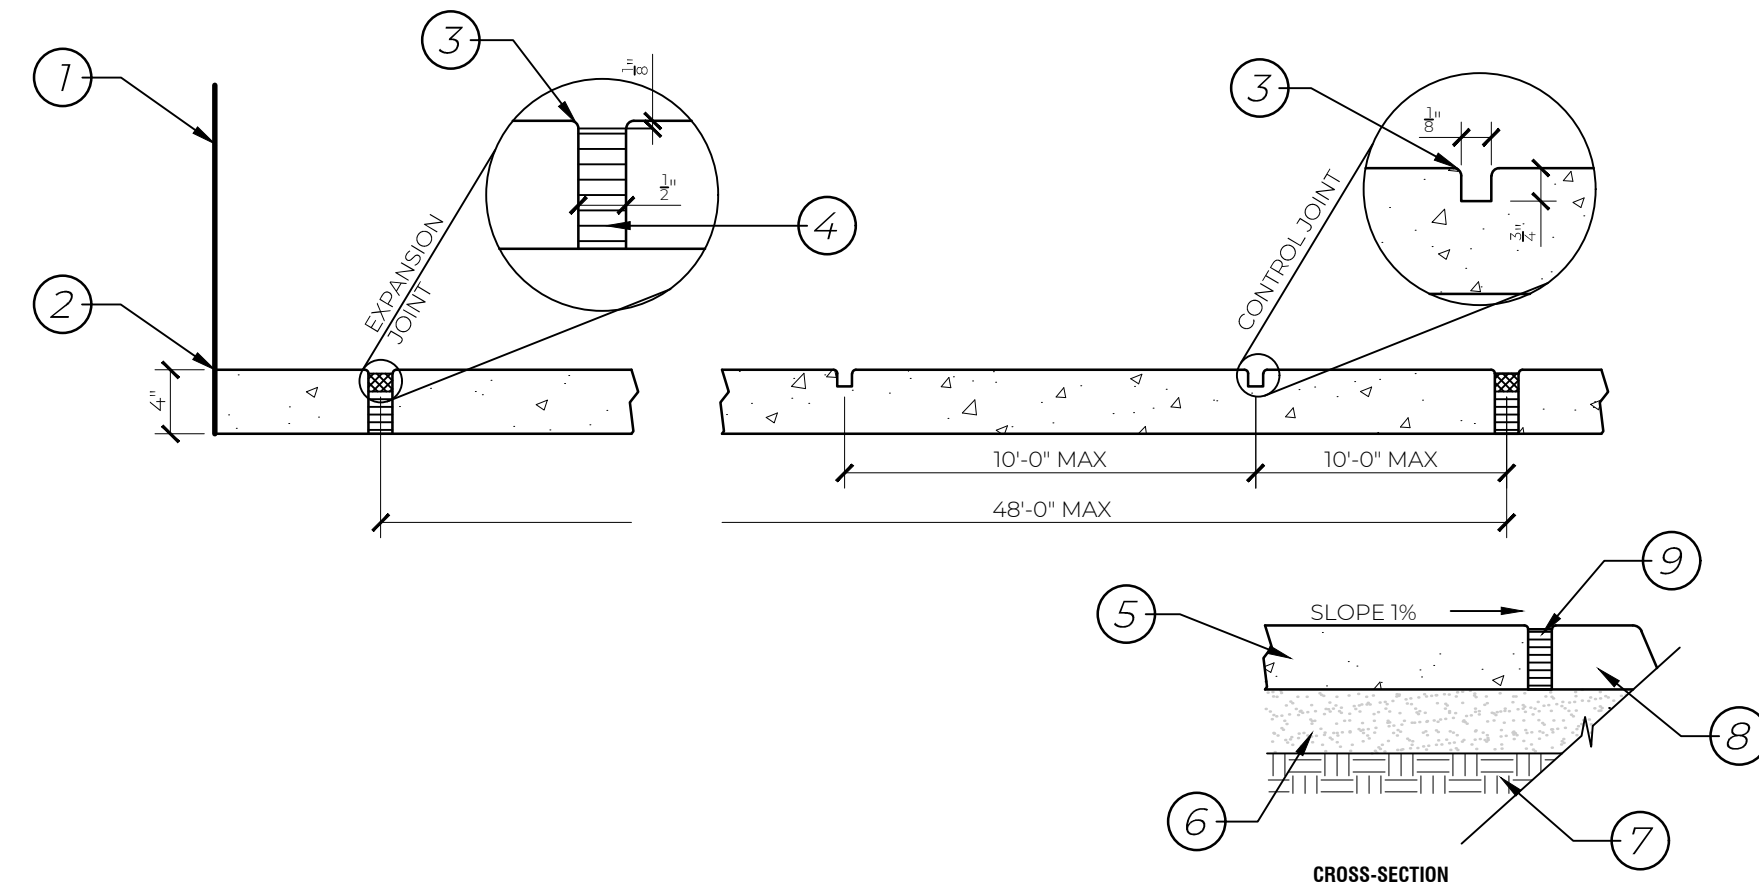


**2 CONCRETE JOINT SECTIONS**  
1" = 1'-0"  
P-PA-HYRI-03

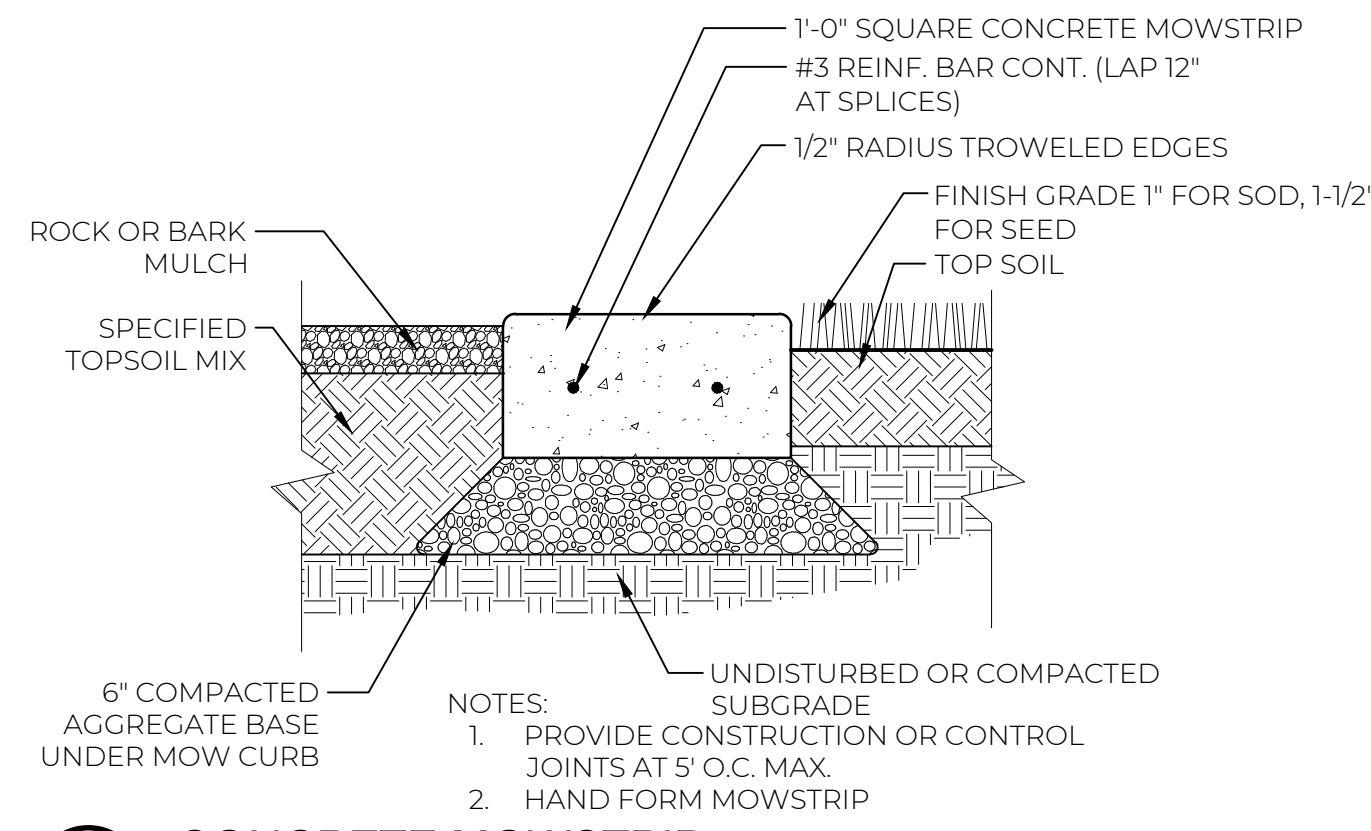


**4 CONCRETE MOWSTRIP**  
1 1/2" = 1'-0"  
P-PA-HYRI-01

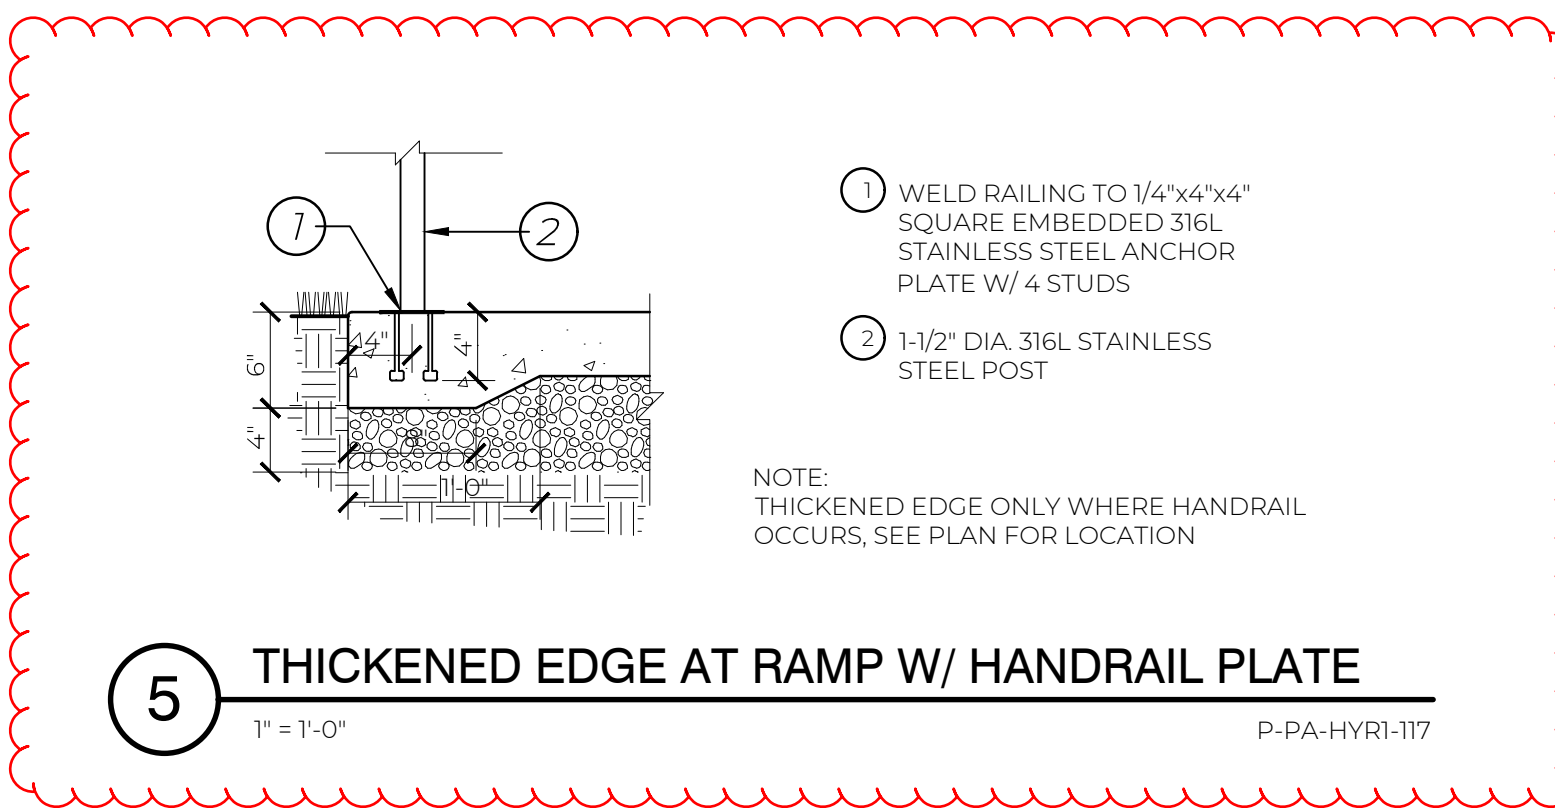


**5 THICKENED EDGE AT RAMP W/ HANDRAIL PLATE**  
1" = 1'-0"  
P-PA-HYRI-117

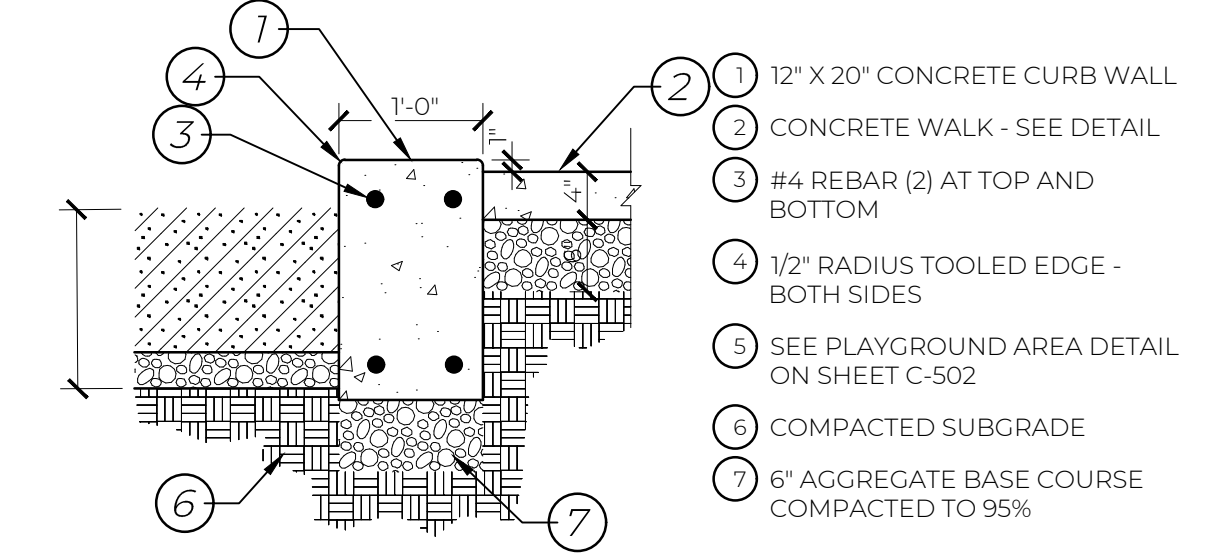


**6 PLAYGROUND EDGE**  
3/4" = 1'-0"  
P-PA-HYRI-17

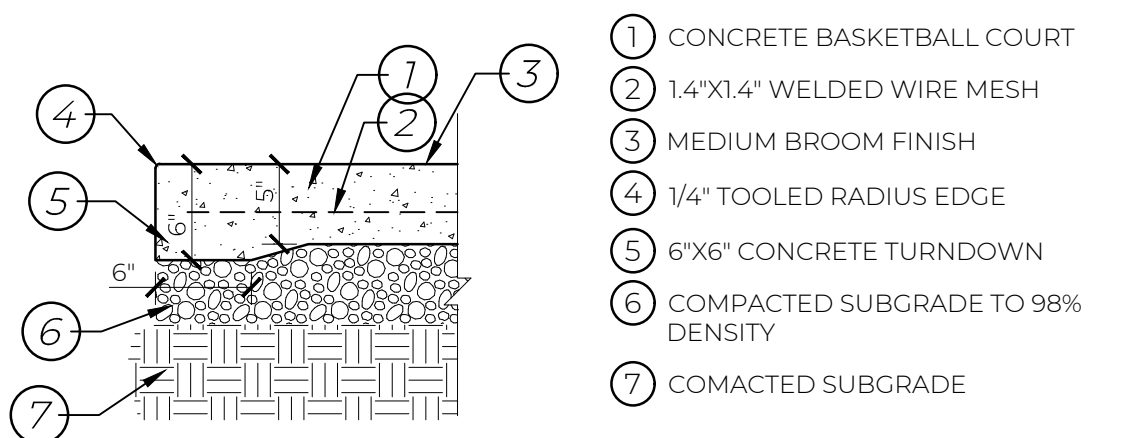


**7 CONCRETE BASKETBALL COURT**  
1" = 1'-0"  
P-PA-HYRI-111

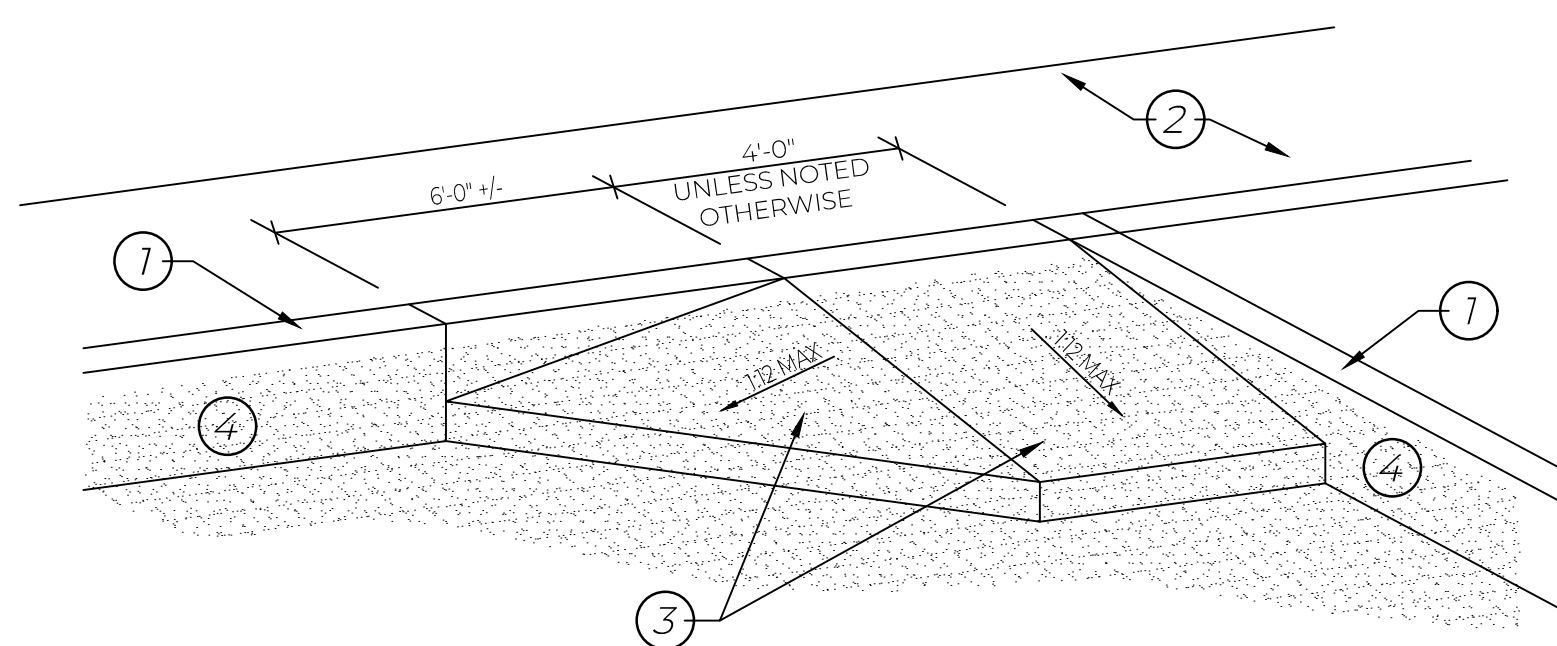


**8 PLAYGROUND RAMP**  
3/8" = 1'-0"  
P-PA-HYRI-53

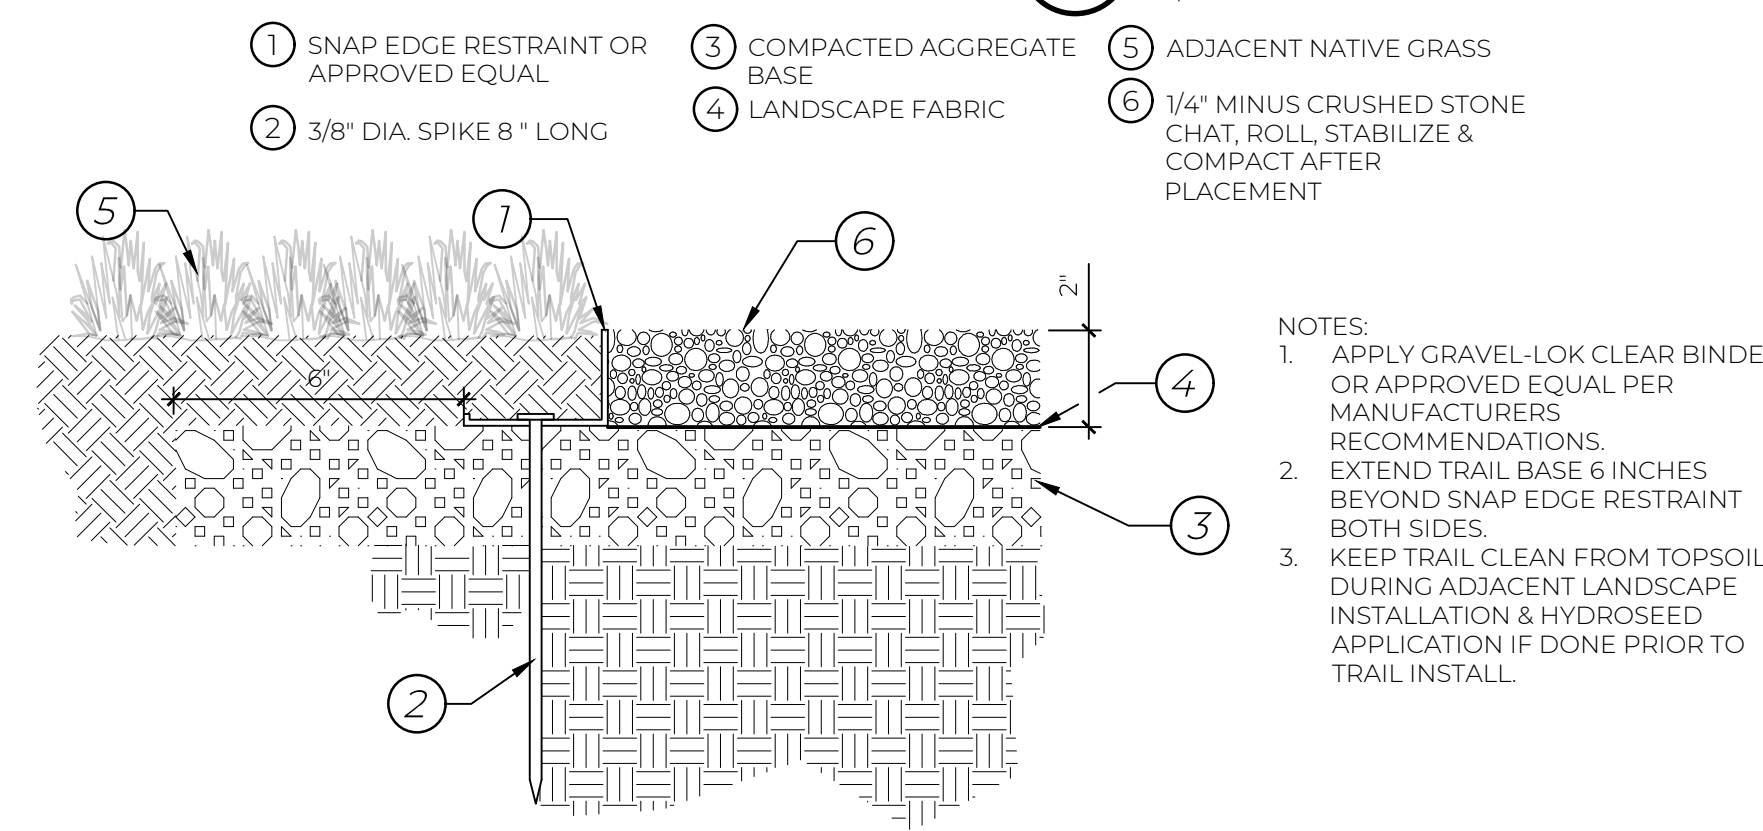


**9 GRAVEL TRAIL & EDGING**  
3" = 1'-0"  
P-PA-HYRI-113

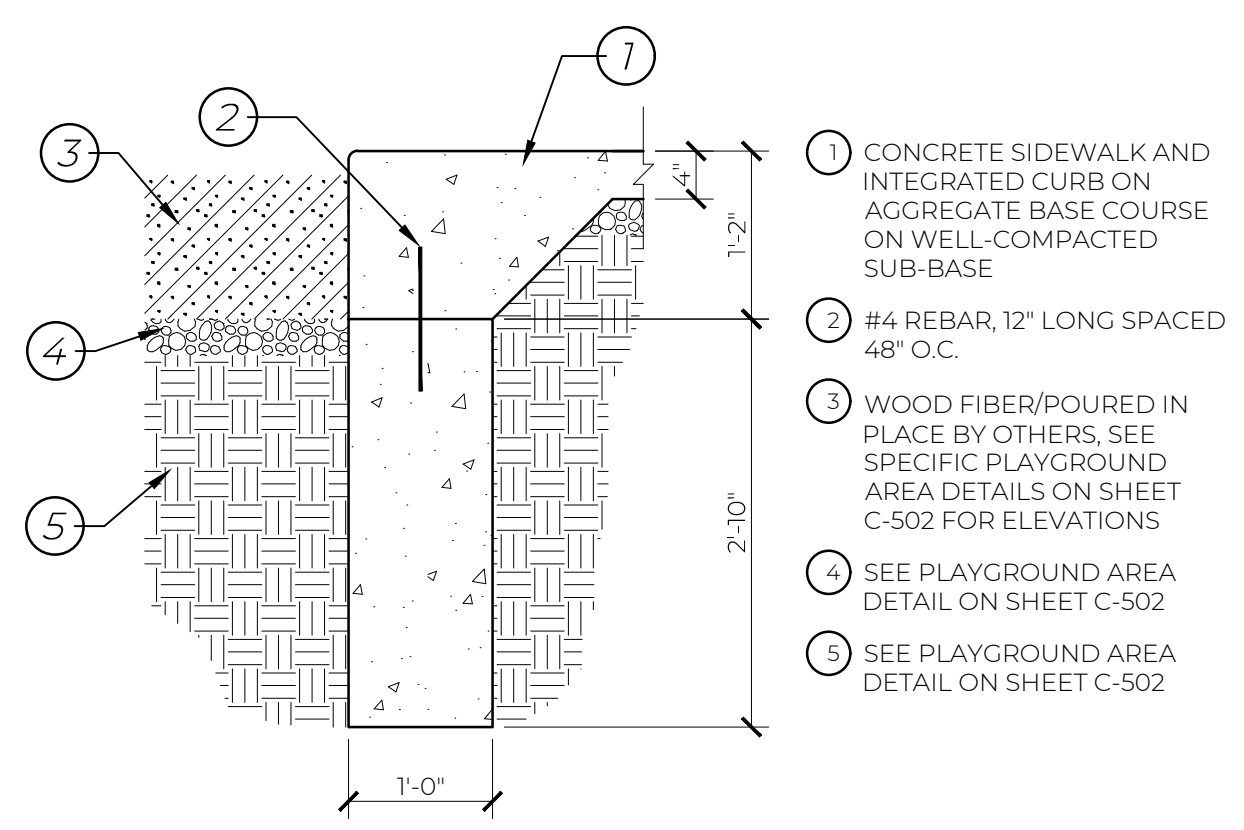

**10 PLAYGROUND EDGE AT WALK**  
3/4" = 1'-0"  
P-PA-HYRI-102

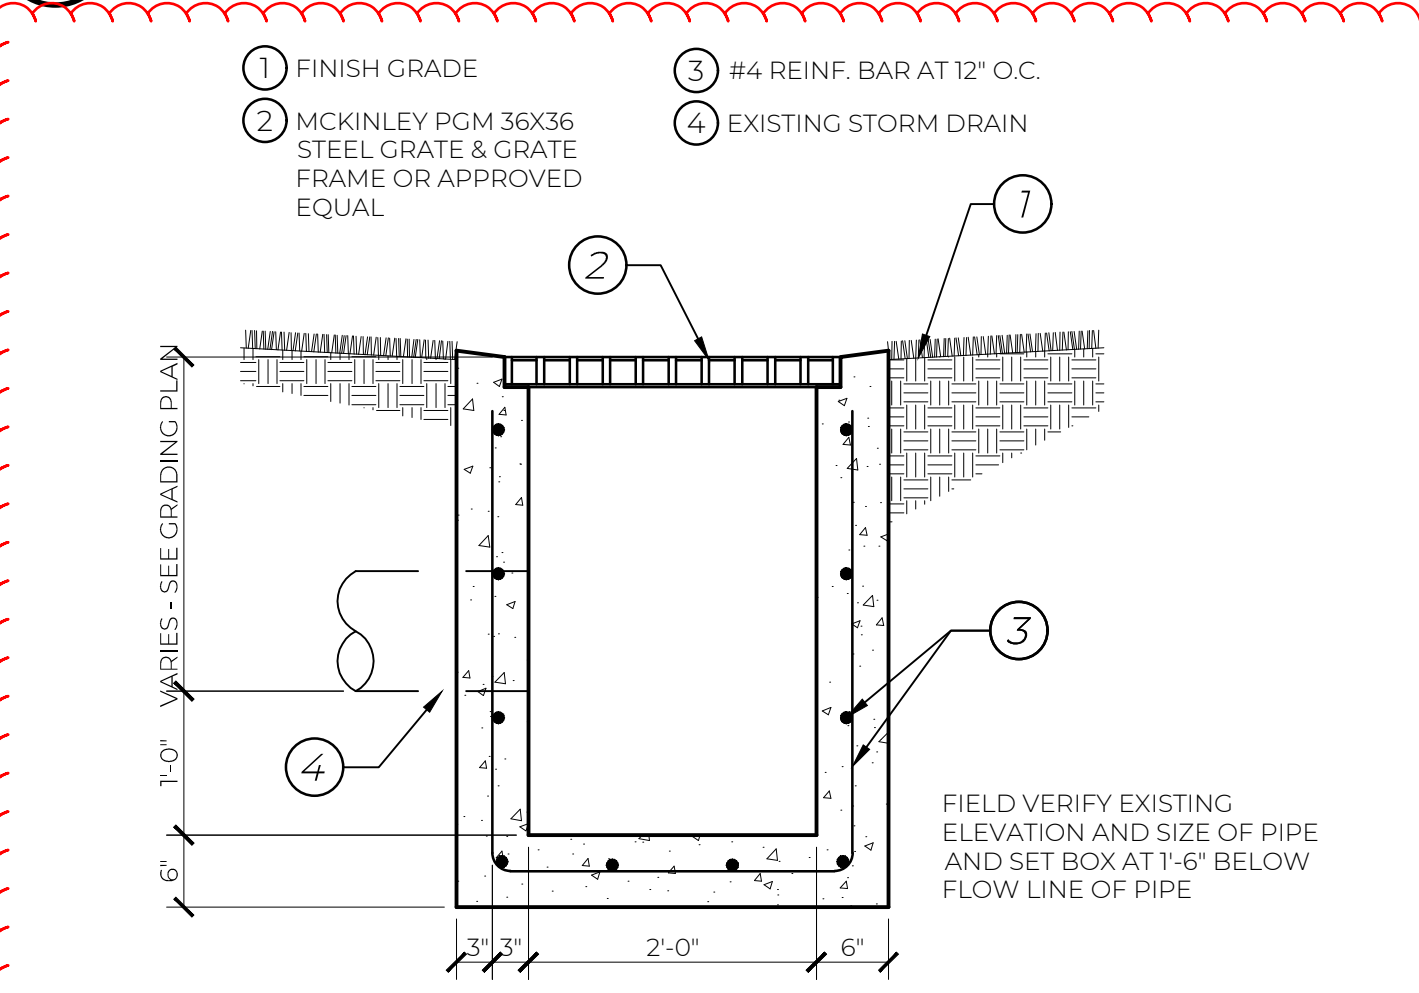

**11 AREA DRAIN**  
3/4" = 1'-0"  
P-PA-HYRI-118

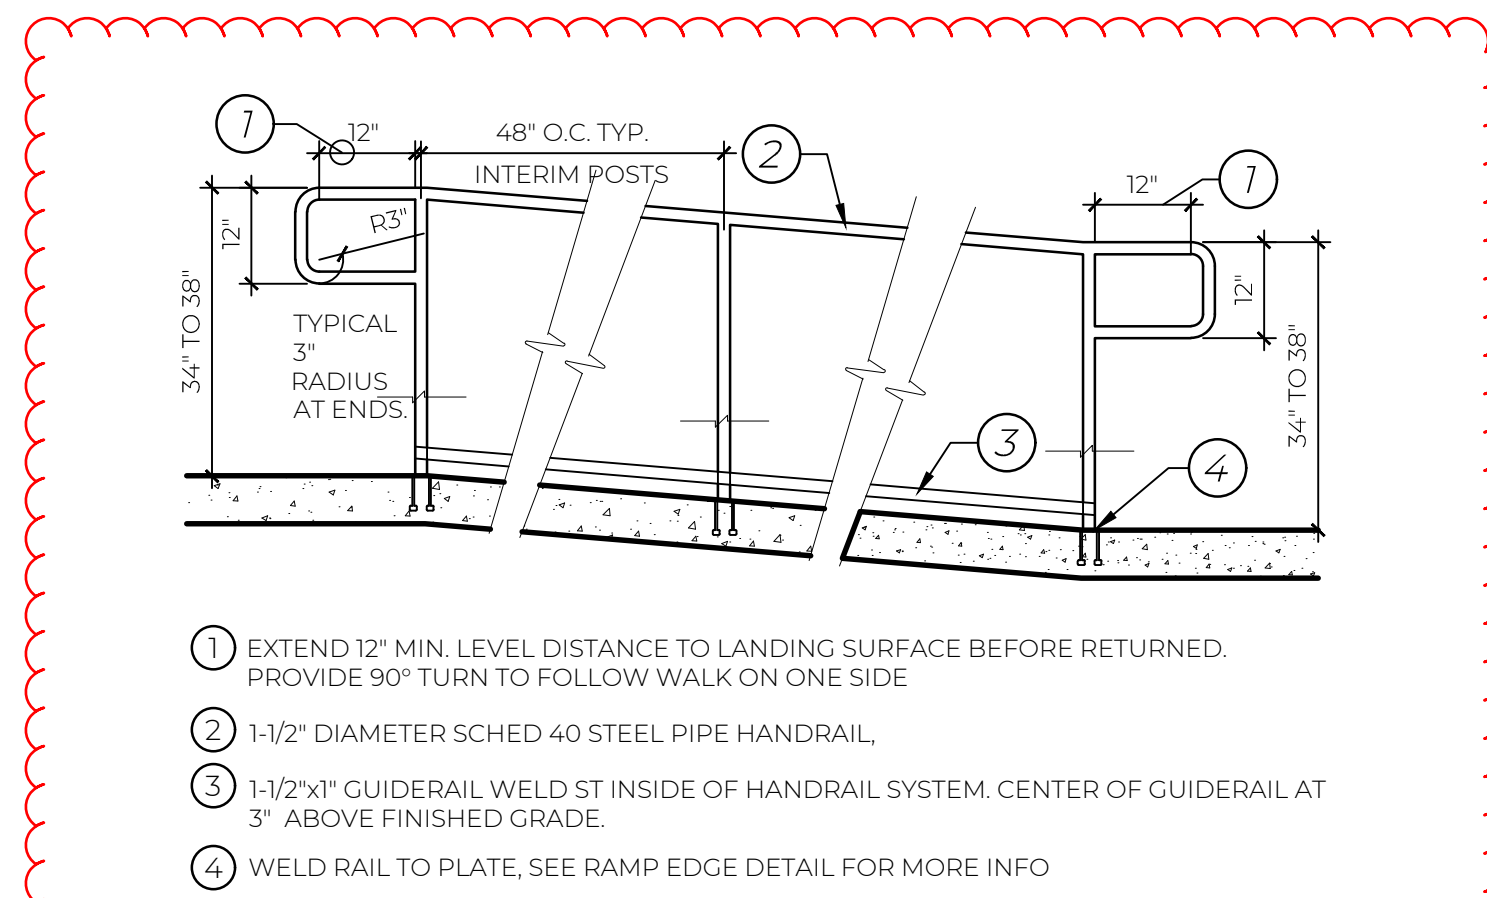

**12 HANDRAIL AT RAMP**  
1/2" = 1'-0"  
P-PA-HYRI-115

**SITE DETAILS**

TITLE	LIBBIE SPRINGS PARK
PROJECT	HYRUM CITY
CLIENT	20 NORTH 680 WEST, HYRUM, UT 84319
ADDRESS	

**REVISIONS**

NO.	DATE	DESCRIPTION
ADD	2025.02.19	REVISE DETAILS



DATE: 02-04-2025  
JOB NUMBER: 80015  
CHECKED BY: HISLOP

SHEET  
**C500**

ALL DRAWINGS, SPECIFICATIONS, DESIGNS AND IDEAS REPRESENTED HEREIN ARE AND SHALL REMAIN THE PROPERTY OF THE DESIGNER. NO PART THEREOF SHALL BE COPIED AND/OR DISCLOSED TO OTHERS OR USED IN CONJUNCTION WITH ANY OTHER PROJECT OTHER THAN THE SPECIFIC PROJECT FOR WHICH THEY HAVE BEEN PREPARED WITHOUT THE WRITTEN CONSENT OF THE DESIGNER. WRITTEN DIMENSIONS OF THESE DRAWINGS SHALL HAVE PRECEDENCE OVER SCALED DIMENSIONS. CONTRACTORS SHALL VERIFY AND BE RESPONSIBLE FOR ANY VARIATIONS FROM THE DIMENSIONS AND CONDITIONS SHOWN BY THEIR DRAWINGS. COPYRIGHT © 2025 PRIME LANDSCAPE ARCHITECTURE, LLC.