

This Addendum shall be considered part of the bid documents for the above-mentioned project as though it had been issued at the same time and shall be incorporated integrally therewith. Where provisions of the following supplementary data differ from those of the original bid documents. This Addendum shall govern and take precedence. ***Bidders Must acknowledge this addendum on their bids.***

Proposers are hereby notified that they shall make any necessary adjustments in their estimates as a result of this Addendum. It will be construed that each bidder's proposal is submitted with full knowledge of all modifications and supplemental data specified herein.

Except as described below, the original bid documents remain unchanged. The bid documents are modified and/or clarified, As follows:

Items:

Bidder questions Responses

- 01.01 G-001 – PROJECT INFORMATION
 - Update Sheet Index

- 01.02 A1 – 113.3 – PLAN – PHASE 1 – LEVEL 01 AREA C - FINISH
 - Added P2 callout tag in corridor to callout paint over existing mural
 - Added manual roller shade text and symbol to legend
 - Added Corner Guards

- 01.03 A1-114.1 – PLAN – PHASE 1 – LEVEL 01 – AREA D – DIMENSION
 - Updated locker locations to Phase II

- 01.04 A1-114.2 – PLAN – PHASE 1 – LEVEL 01 – AREA D – ANNOTATION
 - Updated locker locations to Phase II

- 01.05 A1-114.3 – PLAN – PHASE 1 – LEVEL 01 – AREA D – FINISH
 - Updated locker locations to Phase II
 - Updated Legend Roller shades and corner guards notes

- 01.06 A1-115.3 – PLAN – PHASE 1 – LEVEL 01 – AREA E – FINISH
 - Added Corner Guards

- 01.07 A2-111.1 – PLAN – PHASE 2 – LEVEL 01 – AREA D – DIMENSION
 - Updated locker location of relocated 2 tier lockers

- 01.08 A2-111.2 – PLAN – PHASE 2 – LEVEL 01 – AREA D – ANNOTATION
 - Updated locker location of relocated 2 tier lockers

- 01.09 A2-111.3 – PLAN – PHASE 2 – LEVEL 01 – AREA A - FINISH
 - Added manual roller shades to (7) windows.
 - @ 2 exterior windows in Reception A101
 - @ 4 interior windows in Reception A101

- @ 1 exterior window in Principal A102A
 - Added manual roller shade text and symbol to legend
 - Updated locker location of relocated 2 tier lockers
 - Added Corner Guards
- 01.10 A2-114.1 – PLAN – PHASE 2 – LEVEL 01 – AREA D – DIMENSION
- Add sheet
 - Updated locker location of relocated 2 tier lockers
- 01.11 A2-114.2 – PLAN – PHASE 2 – LEVEL 01 – AREA D – ANNOTATION
- Add sheet
 - Updated locker location of relocated 2 tier lockers
- 01.12 A – 412 – ENLARGED VIEWS
- Updated Legend
 - Added Casework elevation and layout
- 01.13 A – 491 – ENLARGED VIEWS
- Added elevation D1
 - Updated Locker elevations A1 and A2
 - Updated Locker detail reference B1 and C1
- 01.14 A – 591 – DETAILS - MILLWORK
- Added detail D5 millwork
- 01.15 A – 681 – SCHEDULE - SIGNAGE
- Added Type K
 - Updated Signage schedule
- 01.16 A-691 – SCHEDULE – FINISH
- Added WINDOW COVERINGS section
 - WC1 new finish added for roller shades
 - Added P2 to PAINT section
 - Updated Corner guard information
- 01.17 See attached Plumbing items

Michael Rigby	3.3.2026
<hr/>	
ISSUED BY	Date
Architect	



QUESTIONS FOR OWNER /ARCHITECT / ENGINEERS

Spring Creek Elementary Retrofit
February 27, 2026

1. In phase 2 of area A, there are some lockers called out for demolition and some new lockers shown in area A. Will those lockers be new or are they to be the salvaged lockers? **Lockers in the main building will be salvaged. 17 (2 tier lockers) in area A and 7 in area D. Phase II**
2. On sheet A491, there is a call out for a locker detail on A5/A591, but that appears to be a millwork detail. Is there another detail that should take its place?
See Addendum 1 - Updated view reference
3. On the phase 1 finish plans, the flooring in the vestibule of area E is called out as walk off carpet. On the alternate sheets it is calling out LVT in the same area. Please clarify.
Walk-off in the base bid is correct. Bid-alt it shows LVT which is also correct.
4. There is a symbol indicating the call out for corner guards, but none shown on the floor plans. Please clarify if there are corner guards that need to be installed.
See Addendum 1 for locations
5. The plans call out 2 separate items for feminine napkin disposal and vendor, but the specs call for a combo disposal/vendor. Which one is correct?
See Addendum 1 - to match specification combo
6. What size is the signage type K?
See Addendum 01 - updated to Ref. to type J and added Type K
7. During the pre-bid walkthrough, one of our millwork subs said it would be roughly the same cost to replace the countertop and millwork where they are called out to be lowered. Is this acceptable or should this be a VE item post bid?
This can be a VE item Post Bid
8. From one of our plumbing subs: The specs show PEX & copper as acceptable materials as well as PVC and cast iron. Is there one preferred over the other in each case? It is hard to bid equally with the cost difference in the materials respectively. He also stated that there is a note calling for the PVC/ABS DWV pipe to be insulated. Is this necessary where there is no fire rating specified?
See Addendum 01 - Plumbing Items
9. Is the mural in the hallway still being painted over?
See Addendum 1 - Paint and Tackboards
10. With Don requesting that we still try and VE the locker rooms, should we still have subs bid all the plumbing demo that is called out? Is this something that we could possibly look at moving to phase 2? Or should we bid out per plan and VE post bid?
Bid Per plan, can be a post bid VE item

SHEET INDEX

NOTE: THE CONSTRUCTION DOCUMENTS FOR THIS PROJECT ARE COMPOSED OF SETS OF DRAWINGS AND SPECIFICATIONS, AND THEREFORE SHALL BE USED AND MAINTAINED IN THEIR ENTIRETY. ANY CONTRACTOR, SUBCONTRACTOR, VENDOR OR PARTY PARTICIPATING IN OR BIDDING ON THIS PROJECT SHALL BE EXPECTED TO PERFORM DUE DILIGENCE TO ENSURE THEIR BID, WORK PERFORMED, AND MATERIALS PROVIDED CONFORMS TO THE INFORMATION PROVIDED WITHIN ANY AND ALL SHEETS OF DRAWINGS AND SPECIFICATIONS, INCLUDING, BUT NOT LIMITED TO, ANY SUBSEQUENT ADDENDA OR CLARIFICATIONS THAT MAY BE ISSUED RELEVANT TO THEIR SCOPE OF WORK. PROJECT SCOPE MAY BE DEFINED WITHIN SPECIFICATIONS AND/OR DRAWINGS.

ADDITIONALLY, DRAWINGS MAY NOT BE RE-SCALED WHEN PRINTED. WRITTEN DIMENSIONS SHALL HAVE PRECEDENCE, AND LARGER SCALE DRAWINGS SHALL HAVE PRECEDENCE OVER SMALLER SCALE DRAWINGS.

ANY DEVIATION FROM OR CONFLICT WITHIN THE DRAWINGS AND/OR SPECIFICATIONS, MUST BE SUBMITTED VIA REQUEST FOR INFORMATION (RFI) AND RESPONDED TO BY THE ARCHITECT PRIOR TO BID OR BEFORE CONTINUING THAT PORTION OF WORK.

GENERAL:	
G-001	PROJECT INFORMATION
G-002	CODE REVIEW
LANDSCAPE:	
L1-101	LANDSCAPE PLAN
L1-501	LANDSCAPE DETAILS
STRUCTURAL:	
S-001	GENERAL STRUCTURAL NOTES
S-002	GENERAL STRUCTURAL NOTES
S-004	SPECIAL INSPECTION
S-005	SPECIAL INSPECTION
S-010	LEGEND AND ABBREVIATIONS
S1-101	PHASE 1 - STRUCTURAL PLANS
S2-101	PHASE 2 - STRUCTURAL PLANS
S-501	DETAILS
S-502	DETAILS
S-601	SCHEDULES

ARCHITECTURAL DEMO:	
AD1-101	PLAN - DEMOLITION - OVERALL
AD1-111.1	PLAN - PHASE 1 - LEVEL 01 - AREA A - DEMOLITION
AD1-113.1	PLAN - PHASE 1 - LEVEL 01 - AREA C - DEMOLITION
AD1-113.4	PLAN - PHASE 1 - LEVEL 01 - AREA C - RCP DEMOLITION
AD1-114.1	PLAN - PHASE 1 - LEVEL 01 - AREA D - DEMOLITION
AD1-115.1	PLAN - PHASE 1 - LEVEL 01 - AREA E - DEMOLITION
AD1-115.4	PLAN - PHASE 1 - LEVEL 01 - AREA E - RCP DEMOLITION
AD2-111.1	PLAN - PHASE 2 - LEVEL 01 - AREA A - DEMOLITION
AD2-111.4	PLAN - PHASE 2 - LEVEL 01 - AREA A - RCP DEMOLITION

ARCHITECTURAL:	
A1-101	PLAN - PHASE 1 - OVERALL
A1-111.1	PLAN - PHASE 1 - LEVEL 01 - AREA A - DIMENSION
A1-111.2	PLAN - PHASE 1 - LEVEL 01 - AREA A - ANNOTATION
A1-112.3	PLAN - PHASE 1 - LEVEL 01 - AREA B - FINISH
A1-113.1	PLAN - PHASE 1 - LEVEL 01 - AREA C - DIMENSION
A1-113.2	PLAN - PHASE 1 - LEVEL 01 - AREA C - ANNOTATION
A1-113.3	PLAN - PHASE 1 - LEVEL 01 - AREA C - FINISH
A1-113.4	PLAN - PHASE 1 - LEVEL 01 - AREA C - REFLECTED CEILING
A1-114.1	PLAN - PHASE 1 - LEVEL 01 - AREA D - DIMENSION
A1-114.2	PLAN - PHASE 1 - LEVEL 01 - AREA D - ANNOTATION
A1-114.3	PLAN - PHASE 1 - LEVEL 01 - AREA D - FINISH
A1-115.1	PLAN - PHASE 1 - LEVEL 01 - AREA E - DIMENSION
A1-115.2	PLAN - PHASE 1 - LEVEL 01 - AREA E - ANNOTATION
A1-115.3	PLAN - PHASE 1 - LEVEL 01 - AREA E - FINISH
A1-115.4	PLAN - PHASE 1 - LEVEL 01 - AREA E - REFLECTED CEILING
A2-101	PLAN - PHASE 2 - OVERALL
A2-111.1	PLAN - PHASE 2 - LEVEL 01 - AREA A - DIMENSION
A2-111.2	PLAN - PHASE 2 - LEVEL 01 - AREA A - ANNOTATION
A2-111.3	PLAN - PHASE 2 - LEVEL 01 - AREA A - FINISH
A2-111.4	PLAN - PHASE 2 - LEVEL 01 - AREA A - REFLECTED CEILING
A2-114.1	PLAN - PHASE 2 - LEVEL 01 - AREA D - DIMENSION
A2-114.2	PLAN - PHASE 2 - LEVEL 01 - AREA D - ANNOTATION
A-411	ENLARGED VIEWS
A-412	ENLARGED VIEWS

MECHANICAL:	
M-000	GENERAL NOTES AND SCHEDULES
M-001	GENERAL NOTES AND SCHEDULES
M-002	MECHANICAL DETAILS
M-101	MECHANICAL PLAN - OVERALL
MD1-111	LEVEL 1 - AREA A MECHANICAL DEMO PLAN PHASE 1
MD1-113	LEVEL 1 - AREA C MECHANICAL DEMO PLAN PHASE 1
MD1-115	LEVEL 1 - AREA E MECHANICAL DEMO PLAN PHASE 1
MD2-111	LEVEL 1 - AREA A MECHANICAL DEMO PLAN PHASE 2
MR1-111	LEVEL 1 - AREA A MECHANICAL PLAN PHASE 1
MR1-113	LEVEL 1 - AREA C MECHANICAL PLAN PHASE 1
MR1-115	LEVEL 1 - AREA E MECHANICAL PLAN PHASE 1
MR1-800	MECHANICAL BID ALTERNATE PHASE 1
MR2-111	LEVEL 1 - AREA A MECHANICAL PLAN PHASE 2

MECHANICAL:	
M-000	GENERAL NOTES AND SCHEDULES
M-001	GENERAL NOTES AND SCHEDULES
M-002	MECHANICAL DETAILS
M-101	MECHANICAL PLAN - OVERALL
MD1-111	LEVEL 1 - AREA A MECHANICAL DEMO PLAN PHASE 1
MD1-113	LEVEL 1 - AREA C MECHANICAL DEMO PLAN PHASE 1
MD1-115	LEVEL 1 - AREA E MECHANICAL DEMO PLAN PHASE 1
MD2-111	LEVEL 1 - AREA A MECHANICAL DEMO PLAN PHASE 2
MR1-111	LEVEL 1 - AREA A MECHANICAL PLAN PHASE 1
MR1-113	LEVEL 1 - AREA C MECHANICAL PLAN PHASE 1
MR1-115	LEVEL 1 - AREA E MECHANICAL PLAN PHASE 1
MR1-800	MECHANICAL BID ALTERNATE PHASE 1
MR2-111	LEVEL 1 - AREA A MECHANICAL PLAN PHASE 2

PLUMBING:	
P-000	PLUMBING NOTES AND SCHEDULES
P-101	PLUMBING DETAILS
PD1-111	LEVEL 1 - AREA A PLUMBING DEMO PLAN PHASE 1
PD1-113	LEVEL 1 - AREA C PLUMBING DEMO PLAN PHASE 1
PD1-114	LEVEL 1 - AREA D PLUMBING DEMO PLAN PHASE 1
PD1-115	LEVEL 1 - AREA E PLUMBING DEMO PLAN PHASE 1
PD2-111	LEVEL 1 - AREA A PLUMBING DEMO PLAN PHASE 2
PR1-111	LEVEL 1 - AREA A PLUMBING REMODEL PLAN PHASE 1
PR1-113	LEVEL 1 - AREA C PLUMBING REMODEL PLAN PHASE 1
PR1-115	LEVEL 1 - AREA E PLUMBING REMODEL PLAN PHASE 1
PR1-800	LEVEL 1 - AREA A PLUMBING BID ALTERNATE PLAN PHASE 1
PR2-111	LEVEL 1 - AREA A PLUMBING REMODEL PHASE 2

ELECTRICAL:	
E-000	GENERAL NOTES AND SCHEDULES
E-001	PANEL SCHEDULES AND PARTIAL RISER
ED1-113	LEVEL 1 - AREA C ELECTRICAL DEMO PLAN PHASE 1
ED1-114	LEVEL 1 - AREA D ELECTRICAL DEMO PLAN PHASE 1
ED1-115	LEVEL 1 - AREA E ELECTRICAL DEMO PLAN PHASE 1
ED2-111	LEVEL 1 - AREA A ELECTRICAL DEMO PLAN PHASE 2
EL1-113	LEVEL 1 - AREA C LIGHTING PLAN PHASE 1

EL1-115	LEVEL 1 - AREA E LIGHTING PLAN PHASE 1
EL2-111	LEVEL 1 - AREA A LIGHTING PLAN PHASE 2
EP1-113	LEVEL 1 - AREA C POWER PLAN PHASE 1
EP1-114	LEVEL 1 - AREA D POWER PLAN PHASE 1
EP1-115	LEVEL 1 - AREA E POWER PLAN PHASE 1
EP2-111	LEVEL 1 - AREA A POWER PLAN PHASE 2
ET1-113	LEVEL 1 - AREA C AUX PLAN PHASE 1
ET1-115	LEVEL 1 - AREA E AUX PLAN PHASE 1
ET2-111	LEVEL 1 - AREA A AUX PLAN PHASE 2

FIRE PROTECTION:	
FA1-113	LEVEL 1 - AREA C FIRE ALARM PLAN PHASE 1
FA1-115	LEVEL 1 - AREA E FIRE ALARM PLAN PHASE 1
FA2-111	LEVEL 1 - AREA A FIRE ALARM PLAN PHASE 2

DESIGN TEAM

ARCHITECTURAL

DESIGN WEST ARCHITECTS
 255 SOUTH 300 WEST - 795 NORTH 400 WEST
 LOGAN, UT 84321 - SALT LAKE CITY, UT 84103
 PHONE: 435.752.7031 - 801.539.8221
 EMAIL: michael@designwestarchitects.com
 CONTACT: MICHAEL RIGBY

OWNER

CACHE COUNTY SCHOOL DISTRICT
 84 E 2400 N
 NORTH LOGAN, UT 84341
 PHONE: 801.558.8795
 EMAIL: donald.adams@ccsdut.org
 DONALD ADAMS

STRUCTURAL

BHB CONSULTING ENGINEERS, PC
 2786 SOUTH MAIN STREET
 SALT LAKE CITY, UTAH 84115
 PHONE: 801.355.5656
 EMAIL: dallin.pedersen@bhbengineers.com
 CONTACT: DALLIN PEDERSEN

MECHANICAL

NIELSON ENGINEERING, INC CONSULTING ENGINEERS
 156 NORTH TWELFTH AVENUE
 POCATELLO, IDAHO 83201
 PHONE: 208.232.2577
 EMAIL: ws@nielsoneng.com
 CONTACT: WESLEY STALLINGS

LANDSCAPE

DESIGN WEST ARCHITECTS
 255 SOUTH 300 WEST - 795 NORTH 400 WEST
 LOGAN, UT 84321 - SALT LAKE CITY, UT 84103
 PHONE: 435.752.7031 - 801.539.8221
 EMAIL: kenia@designwestarchitects.com
 CONTACT: KENI ALTHOUSE

ELECTRICAL

NIELSON ENGINEERING, INC CONSULTING ENGINEERS
 156 NORTH TWELFTH AVENUE
 POCATELLO, IDAHO 83201
 PHONE: 208.232.2577
 EMAIL: mi@nielsoneng.com
 CONTACT: MICHAEL INSKIP

ABBREVIATIONS

ABR.	DESCRIPTION	ABR.	DESCRIPTION	ABR.	DESCRIPTION
AB	ANCHOR BOLT	EXIST	EXISTING	PART BD	PARTICLE BOARD
ABS	ACRYLONITRILE-BUTADIENE -STYRENE	EXP	EXPANSION	PARTN	PARTITION
AC	ACOUSTIC, ACOUSTICAL	EXT	EXTERIOR	P-LAM	PLASTIC LAMINATE PLATE
ACC STA	ACCESSIBLE STATION	FD	FLOOR DRAIN	PLYWD	PLYWOOD
AD	ADDENDUM	FDN	FOUNDATION	PREFAB	PREFABRICATED
ADJ	ADJUSTABLE	FEC	FIRE EXTINGUISHER CABINET	PROJ	PROJECTION
AFF	ABOVE FINISH FLOOR	FIN	FINISH	PT	PRESERVATIVE TREATED
ALT	ALTERNATE	FLR	FLOOR	PVC	POLYVINYL CHLORIDE
ALUM	ALUMINUM	FTG	FOOTING	QT	QUARRY TILE
ASI	ARCHITECT SUPPLEMENTAL INSTRUCTION	GA	GAUGE	R/	ROUND
ASPH	ASPHALT	GALV	GALVANIZED	RAD	RADIUS
BB	BASKETBALL	GI	GALVANIZED IRON	RD	ROOF DRAIN
BD	BOARD	GYP BD	GYP SUM BOARD	REF	REFRIGERATOR
BLDG	BUILDING	HDWD	HARDWOOD	REIN	REINFORCE
BLKG	BLOCKING	HM	HOLLOW METAL	REV	REVISION
BM	BENCH MARK	HORIZ	HORIZONTAL	RFI	REQUEST FOR INFORMATION
B.O.	BOTTOM OF	HT	HEIGHT	RO	ROUGH OPENING
BRG	BEARING	ID	INSIDE DIAMETER	SCHED	SCHEDULE
B.SMT	BASEMENT	INSUL	INSULATION	SHT	SHEET
B.U.R.	BUILT UP ROOF	INT	INTERIOR	SIM	SIMILAR
C	CHANNEL	JT	JOINT	SPEC	SPECIFICATION
CB	CHALKBOARD	KD	KNOCK DOWN	SQ	SQUARE
C	CENTER LINE	KO	KNOCK OUT	SS	STAINLESS STEEL
CLG	CEILING	L	ANGLE	STD	STANDARD
CMU	CONCRETE MASONRY UNIT	LLV	LONG LEG VERTICAL	STL	STEEL
CO	CLEAN OUT	MAX	MAXIMUM	STOR	STORAGE
COL	COLUMN	MB	MARKER BOARD	STRUC	STRUCTURAL
CONC	CONCRETE	MECH	MECHANICAL	SUSP	SUSPENDED, SUSPENSION
CONN	CONNECTION	MFR	MANUFACTURER	SYS	SYSTEM
CONT	CONTINUOUS	MH	MANHOLE	T & B	TOP AND BOTTOM
CONTR	CONTRACTOR	MIN	MINIMUM	TB	TACKBOARD
CT	CERAMIC TILE	MISC	MISCELLANEOUS	TEMP	TEMPORARY
d	PENNY	MO	MASONRY OPENING	TEL	TELEPHONE
DIM	DIMENSION	MT	MOUNT	THRES	THRESHOLD
DS	DOWNSPOUT	MTL	METAL	TS	TUBE STEEL
DWG	DRAWING	(N)	NEW	T.O.	TOP OF
(E)	EXISTING	NIC	NOT IN CONTRACT	TOIL	TOILET
EA	EACH	NTS	NOT TO SCALE	TV	TELEVISION
EFS	EXTERIOR INSULATION FINISH SYSTEM	O.C.	ON CENTER	TYP	TYPICAL
ELECT	ELECTRICAL	OD	OUTSIDE DIAMETER	VERT	VERTICAL
ELEV	ELEVATION	OH	OVERHEAD	U.N.O.	UNLESS NOTED OTHERWISE
EQ	EQUAL	OF/CI	OWNER FURNISHED / CONTRACTOR INSTALLED	W	WIDE FLANGE
EQUIP	EQUIPMENT	W/	OWNER FURNISHED / CONTRACTOR INSTALLED	W/	WITH
EWC	ELECTRIC WATER COOLER	OPNG	OPENING	WC	WATER CLOSET
		OPP	OPPOSITE	WD	WOOD
		O.T.S.	OPEN TO STRUCTURE	WM	WATER METER
				W/O	WITHOUT
				WWF	WELDED WIRE FABRIC


SYMBOLS LEGEND

DESCRIPTION	SYMBOL	DESCRIPTION	SYMBOL
BUILDING SECTION		DRAWING TAG	
WALL SECTION		WINDOW TYPES	
DETAIL		WALL TYPES	
SECTION DETAIL ENLARGED PLAN		DOOR TAG	
ELEVATION LEVEL		KEYNOTES	
ELEVATIONS		REVISIONS	
ROOM TAG		GRID BUBBLE	
ROOM FINISH TAG		EQUIPMENT TAG	
		FINISH TAG	
		NORTH ARROW	

MATERIALS LEGEND

MATERIAL	SYMBOL
EARTH	
ASPHALT PAVING	
COMPACTED GRANULAR FILL	
CONCRETE	
CONCRETE MASONRY UNITS	
BRICK	
STEEL	
CONTINUOUS WOOD	
WOOD BLOCKING	
PLYWOOD / OSB	
PARTICLE BOARD	
INSULATION	
RIGID INSULATION	
GYP SUM BOARD	
GLU-LAMINATE BEAM	
GLASS	
FINISH WOOD	
ALUMINUM	
WOOD STUD WALL	

VICINITY MAP

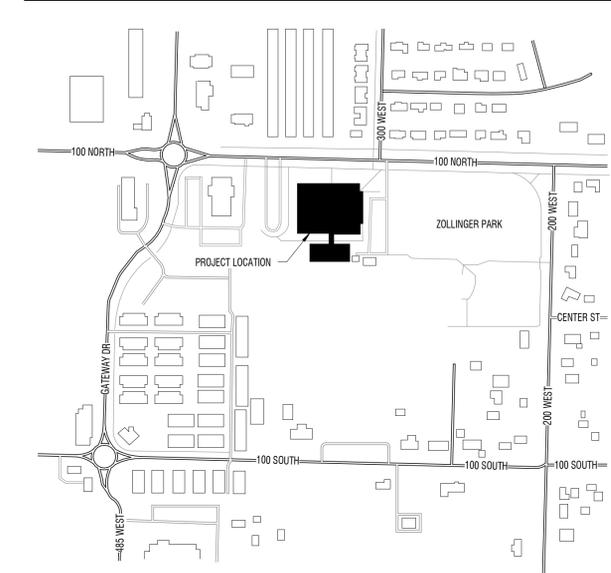


CONSTRUCTION DOCUMENTS



LOGAN, UTAH
 (435) 752-7031
 SALT LAKE CITY, UTAH
 (801) 539-8221

SPRING CREEK ELEMENTARY
REMODEL & ADDITION
 350 W 100 N
 PROVIDENCE, UT 84302
 CACHE COUNTY SCHOOL DISTRICT

MARK	DESCRIPTION	ADENDUM 01
DATE	02.19.2026	
PROJECT #	123008	
DRAWN BY	HARRIS	
CHECKED BY	WILLIAMS	
ISSUED	02.19.2026	

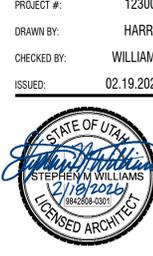

PROJECT INFORMATION
G-001

GENERAL NOTES

- ROOM FINISH TAGS FOR EACH ROOM REPRESENT TYPICAL FINISHES. SPECIFIC WALLS IN SELECTED AREAS MAY HAVE MULTIPLE FINISHES WHICH WILL BE INDICATED IN INTERIOR ELEVATIONS.
- FIELD VERIFY ALL DIMENSIONS PRIOR TO FABRICATION OF CASEWORK AND FINISH ASSEMBLIES
- SEE INTERIOR ELEVATIONS FOR ADDITIONAL FINISH INFORMATION
- SEE REFLECTED CEILING PLANS FOR ADDITIONAL FINISH INFORMATION
- FOR FINISH SCHEDULE SEE SHEET A-591
- FLOOR MATERIAL TRANSITIONS WILL OCCUR BELOW DOORS U.N.O. SEE DETAIL D3/A-593
- FOR TYPICAL TRANSITION/FINISH DETAILS SEE SHEET A-593
- SEE SHEET A-681 FOR SIGNAGE TYPES AND DESCRIPTIONS
- TILED WALLS TO BE FULL HEIGHT OF WALL U.N.O.
- FLOOR COVERING DOES NOT EXTEND UNDER MILLWORK OR CASEWORK, U.N.O.
- INSTALL FLOOR TILE EXPANSION JOINTS AS PER TCNA.
- ALL EXPOSED STRUCTURE TO BE PAINTED U.N.O.


LEGEND

	MILLWORK	ROOM FINISH TAG
	BASE	* = SEE ELEVATIONS FOR FINISH SELECTIONS
	WALL	- = NO FINISH APPLIED
	WALL	
		FINISH TAG - INDICATES SPECIFIC APPLIED FINISH
		INDICATES FINISH IS APPLIED TO AREA BETWEEN ARROWS
		INDICATES FINISH IS APPLIED TO FACE OF SURFACE(S)
		INDICATES SIGNAGE LOCATION
		INDICATES CORNER GUARD - SEE M11 ON FINISH SCHEDULE
		INDICATES A MANUAL ROLLER SHADE.

FINISH LEGEND

	C1 - WALK-OFF		RF1 - LVT
	C2 - CARPET		RF2 - LVT
	T1 - FLOOR TILE		RF3 - LVT
	T2 - WALL TILE		RF4 - LVT
	T3 - WALL TILE		

KEY PLAN - PHASE 1 - LEVEL 01

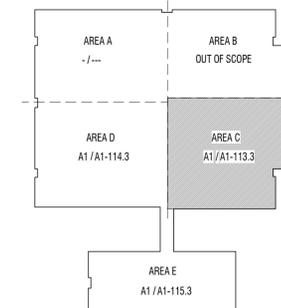

A1 PLAN - FINISH
 1/8" = 1'-0"
 PHASE 1 - LEVEL 01 - AREA C




GENERAL NOTES

- CONTRACTOR SHALL BE FAMILIARIZED WITH THE LAY-OUT OF STRUCTURAL, MECHANICAL, AND ELECTRICAL DRAWINGS. ANY QUESTIONS SHALL BE SUBMITTED VIA REQUEST FOR INFORMATION (RFI).
- ALL INTERIOR DIMENSIONS ARE TO FROM FACE OF STUD / MASONRY. ALL EXTERIOR DIMENSIONS ARE TO FROM FACE OF GRID / FOUNDATION. DIMENSIONS MARKED 'CLEAR' OR 'CLR' ARE FROM FACE OF FINISH TO FACE OF FINISH AND SHALL BE MAINTAINED AND CANNOT BE FIELD ADJUSTED WITHOUT PRIOR APPROVAL OF THE ARCHITECT.
- MIN CLEARANCE REQUIRED ON LATCH SIDE OF DOORS SHALL CONFORM TO ADA REQUIREMENTS
- HINGE SIDE OF DOORS AT PERPENDICULAR WALLS TO HAVE 3" STUD SECTION U.N.O
- ALIGN FURRED WALLS AND STUD WALL FINISH FACE TYPICAL. U.N.O.
- ADA RESTROOMS MUST COMPLY WITH ADA. WATER CLOSET MEASUREMENTS ON SHEET A-551
- DOOR AND WINDOWS OPENINGS ARE INDICATED WITH ANNOTATION SYMBOLS AND ARE FURTHER IDENTIFIED ON DOOR AND WINDOW SCHEDULES. SEE BOTH FLOOR PLANS AND EXTERIOR ELEVATIONS FOR ALL REFERENCES. DIMENSIONS TO FRAMES WILL BE TO OUTSIDE EDGE OF FRAME. CONTRACTOR SHALL CONFIRM ROUGH OPENING WITH MANUFACTURER.
- SUB-CONTRACTORS SHALL VERIFY ALL DIMENSIONS FOR THEIR WORK.
- SEE STRUCTURAL DRAWINGS FOR TOTAL VERTICAL DISPLACEMENT OF WOOD FRAMING DUE TO SHRINKAGE AND EXPANSION FOR HEIGHT OF BUILDING. CONSTRUCTION OF PLUMBING STACKS AND RISERS SHALL ACCOUNT FOR MOVEMENT OF FRAMING OVER TIME.
- WALL TYPES SHOWN AS $\text{---} \text{---} \text{---}$ (S6A) ARE SHOWN ON SHEET A-611. FOR EXTERIOR WALLS SEE BUILDING & WALL SECTIONS. FOR STANDARD STEEL STUD DETAILS SEE A-511 & A-512.



KEY PLAN - PHASE 1 - LEVEL 01

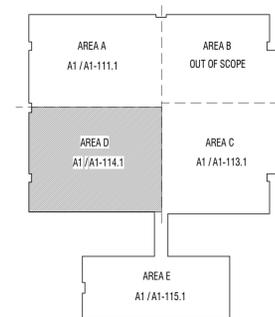

A1 PLAN - DIMENSION
 1/8" = 1'-0"
 AREA D - LEVEL 01



MARK	DESCRIPTION	ADDITIONAL
1	02.19.2026	ADDITIONAL 01



PROJECT #: 123008
 DRAWN BY: Author
 CHECKED BY: Checker
 ISSUED: 02.19.2026

A1-114.1

CONSTRUCTION DOCUMENTS


GENERAL NOTES

- KEYNOTES (#) THE FIRST TWO NUMBERS REPRESENT THE RELATED CSI MASTER FORMAT DIVISION. THE SECOND SET OF NUMBERS REPRESENTS AN IDENTIFYING MARK VALUE. NOT ALL VALUES MAY BE USED OR OCCUR IN THE DOCUMENT SET.
 ADDITIONALLY, KEYNOTES RETAIN THEIR ASSIGNED VALUE UNIVERSALLY THROUGHOUT THE SET. THE KEYNOTES LISTED BELOW, REPRESENT THE KEYNOTES FOUND AND UTILIZED ON THIS SHEET AND EACH LIST WILL DIFFER RESPECTIVE TO ITS SHEET. THEREFORE, BASED ON ACTUAL KEYNOTES UTILIZED ON A GIVEN SHEET OF DRAWINGS, GAPS IN THE SEQUENCING WILL OCCUR.
- CONTRACTOR SHALL BE FAMILIARIZED WITH THE LAY-OUT OF STRUCTURAL, MECHANICAL, AND ELECTRICAL DRAWINGS. ANY QUESTIONS SHALL BE SUBMITTED VIA REQUEST FOR INFORMATION (RFI).
- DOOR AND WINDOWS OPENINGS ARE INDICATED WITH ANNOTATION SYMBOLS AND ARE FURTHER IDENTIFIED ON DOOR AND WINDOW SCHEDULES. SEE BOTH FLOOR PLANS AND EXTERIOR ELEVATIONS FOR ALL REFERENCES.
- PROVIDE CONTINUOUS WOOD BLOCKING OR METAL STRAPPING FOR ANY WALL MOUNTED OR SUPPORTED ITEMS. PROVIDE FIRE RATED BLOCKING FOR ANY FIRE RATED PARTITIONS PER A-511
- FEC = FIRE EXTINGUISHER IN SEMI-RECESSED CABINET.
- A1/A-101 INDICATES INTERIOR ROOM ELEVATIONS ON SHEET REFERENCED.
- SEE SHEET SERIES G-002 & A-612 FOR ALL FIRE WALLS, SMOKE WALLS, WALLS TO CEILING LEVEL, SOUND WALLS.
- SEE FINISH PLANS FOR SIGNAGE LOCATION, SIGNAGE SYMBOL.
- SEE SITE PLANS FOR EXTERIOR STAIRS, RAILING AND RAMP DETAILS.
- ROLLER SHADES PER FINISH PLANS.
- EXTEND ALL WALLS SURROUNDING AN OPEN CEILING AREA TO DECK.
- SLOPE ALL SETTING BEDS TO FLOOR DRAINS U.L.O.
- PROVIDE 5/8" PLYWOOD BACKING PANELS AT ELECTRICAL ROOMS AND TELEVISION LOCATIONS FOR EQUIPMENT MOUNTING. PAINT TO MATCH WALLS PER A-511
- BLOCKING TO BE PROVIDED AT SHELVING, CASEWORK, RAILINGS, LIGHT FIXTURE, COUNTERTOP, ACCESSORIES AND MORE PER A-511, TYP

KEYNOTES

#	DESCRIPTION
MARK	

KEY PLAN - PHASE 1 - LEVEL 01

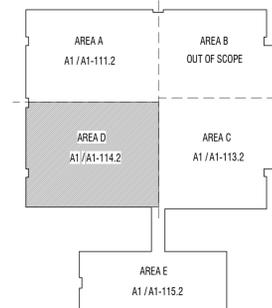

MARK	DESCRIPTION	ADDITIONAL
1	02.19.2026	ADDITIONUM 01
PROJECT #:	123008	
DRAWN BY:	HARRIS	
CHECKED BY:	WILLIAMS	
ISSUED:	02.19.2026	



PLAN - PHASE 1 -
 LEVEL 01 - AREA D -
 ANNOTATION

A1-114.2

CONSTRUCTION DOCUMENTS



A1 PLAN - ANNOTATION

1/8" = 1'-0" AREA D - LEVEL 01



GENERAL NOTES

1. ROOM FINISH TAGS FOR EACH ROOM REPRESENT TYPICAL FINISHES. SPECIFIC WALLS IN SELECTED AREAS MAY HAVE MULTIPLE FINISHES WHICH WILL BE INDICATED IN INTERIOR ELEVATIONS.
2. FIELD VERIFY ALL DIMENSIONS PRIOR TO FABRICATION OF CASEWORK AND FINISH ASSEMBLIES
3. SEE INTERIOR ELEVATIONS FOR ADDITIONAL FINISH INFORMATION
4. SEE REFLECTED CEILING PLANS FOR ADDITIONAL FINISH INFORMATION
5. FOR FINISH SCHEDULE SEE SHEET A-691
6. FLOOR MATERIAL TRANSITIONS WILL OCCUR BELOW DOORS U.N.O. SEE DETAIL D3 / A-593
7. FOR TYPICAL TRANSITION/FINISH DETAILS SEE SHEET A-593
8. SEE SHEET A-681 FOR SIGNAGE TYPES AND DESCRIPTIONS
9. TILED WALLS TO BE FULL HEIGHT OF WALL, U.N.O.
10. FLOOR COVERING DOES NOT EXTEND UNDER MILLWORK OR CASEWORK, U.N.O.
11. INSTALL FLOOR TILE EXPANSION JOINTS AS PER TCNA.
12. ALL EXPOSED STRUCTURE TO BE PAINTED U.N.O.


LEGEND

	<p>MILLWORK BASE WALL WALL</p> <p>ROOM FINISH TAG * = SEE ELEVATIONS FOR FINISH SELECTIONS - = NO FINISH APPLIED</p>
	<p>FINISH TAG - INDICATES SPECIFIC APPLIED FINISH</p>
	<p>INDICATES FINISH IS APPLIED TO AREA BETWEEN ARROWS</p>
	<p>INDICATES FINISH IS APPLIED TO FACE OF SURFACE(S)</p>
	<p>INDICATES SIGNAGE LOCATION</p>
	<p>INDICATES CORNER GUARD - SEE M11 ON FINISH SCHEDULE</p>
	<p>INDICATES A MANUAL ROLLER SHADE.</p>


FINISH LEGEND

	C1 - WALK-OFF		RF1 - LVT
	C2 - CARPET		RF2 - LVT
	T1 - FLOOR TILE		RF3 - LVT
	T2 - WALL TILE		RF4 - LVT
	T3 - WALL TILE		

KEY PLAN - PHASE 1 - LEVEL 01

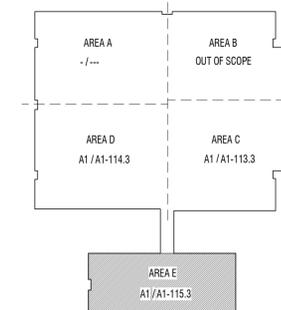

NOTE: RF2 FLOORING STRIP ON PERIMETER OF CORRIDORS TO TERMINATE FLUSH AT OUTSIDE OF EACH DOOR FRAME, ON BOTH SIDES OF DOOR. SEE FINISH PLAN.

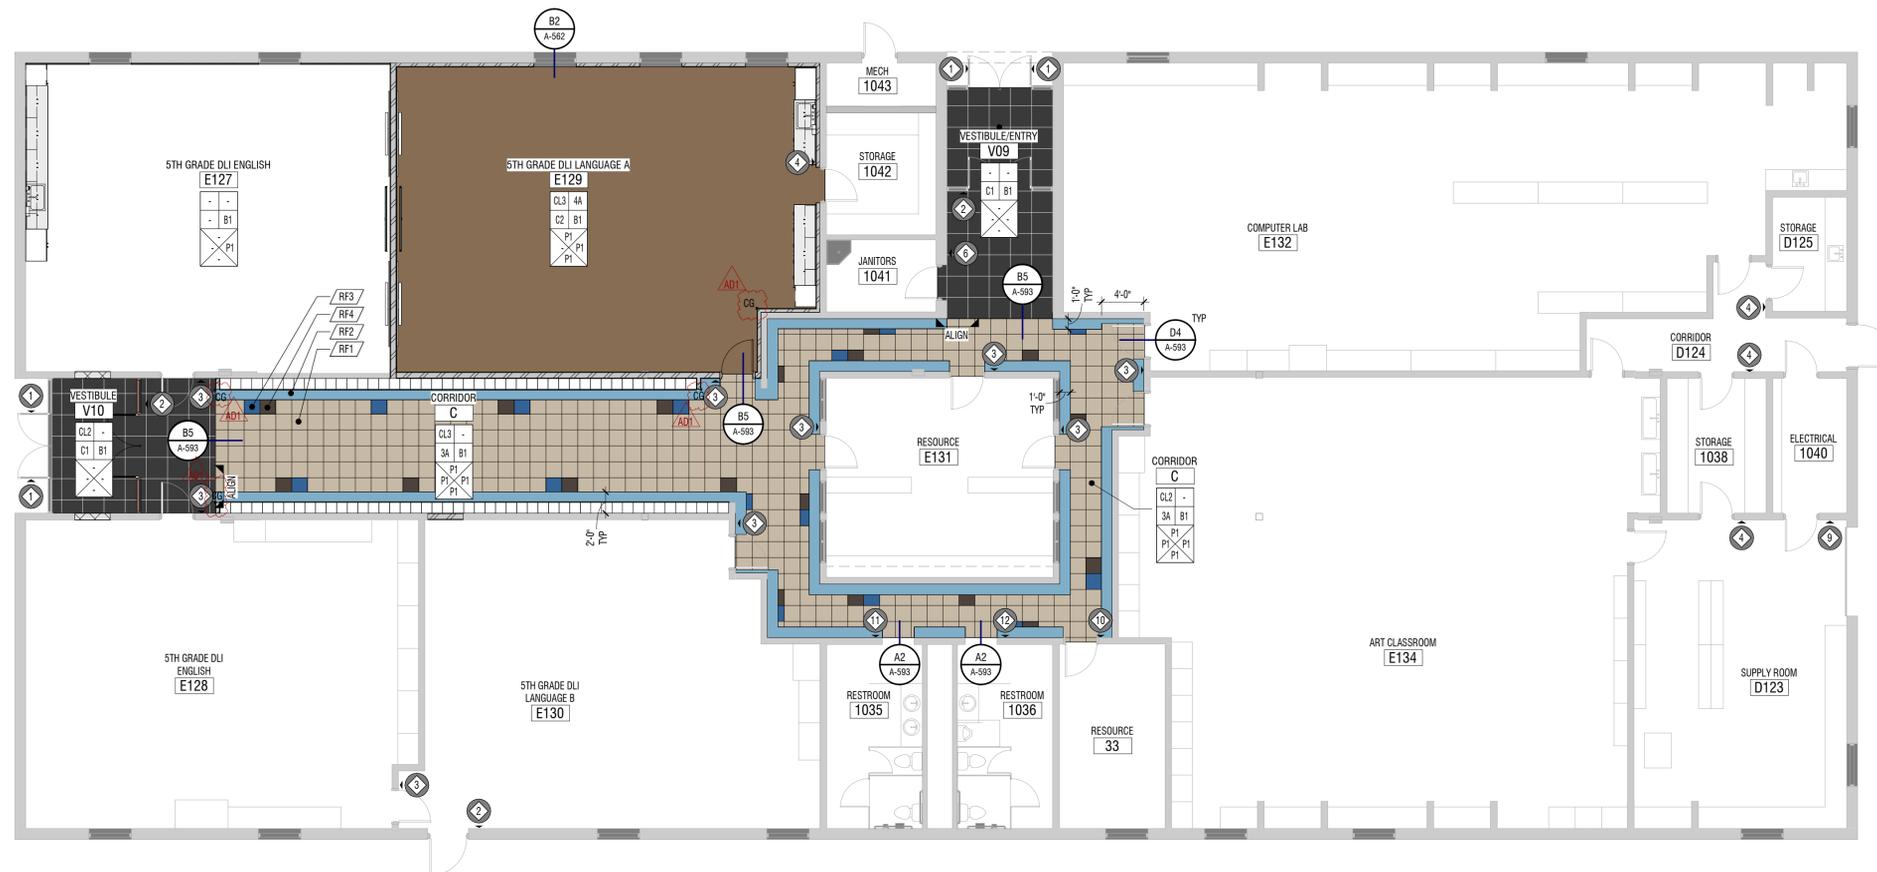

A1 PLAN - FINISH
 1/8" = 1'-0"
 AREA E - LEVEL 01



**SPRING CREEK ELEMENTARY
 REMODEL & ADDITION**
 350 W 100 N
 PROVIDENCE, UT 84332
 CACHE COUNTY SCHOOL DISTRICT

DESCRIPTION:	ADDENDUM 01
DATE:	02.19.2026
PROJECT #:	123008
DRAWN BY:	WK
CHECKED BY:	WILLIAMS
ISSUED:	02.19.2026




PLAN - PHASE 1 -
 LEVEL 01 - AREA E -
 FINISH

A1-115.3


CONSTRUCTION DOCUMENTS

GENERAL NOTES

- CONTRACTOR SHALL BE FAMILIARIZED WITH THE LAY-OUT OF STRUCTURAL, MECHANICAL, AND ELECTRICAL DRAWINGS. ANY QUESTIONS SHALL BE SUBMITTED VIA REQUEST FOR INFORMATION (RFI).
- ALL INTERIOR DIMENSIONS ARE TO FROM FACE OF STUD / MASONRY. ALL EXTERIOR DIMENSIONS ARE TO FROM FACE OF GRID/FOUNDATION. DIMENSIONS MARKED 'CLEAR' OR 'CLR' ARE FROM FACE OF FINISH TO FACE OF FINISH AND SHALL BE MAINTAINED AND CANNOT BE FIELD ADJUSTED WITHOUT PRIOR APPROVAL OF THE ARCHITECT.
- MIN CLEARANCE REQUIRED ON LATCH SIDE OF DOORS SHALL CONFORM TO ADA REQUIREMENTS
- HINGE SIDE OF DOORS AT PERPENDICULAR WALLS TO HAVE 3" STUD SECTION U.N.O.
- ALIGN FURRED WALLS AND STUD WALL FINISH FACE TYPICAL. U.N.O.
- ADA RESTROOMS MUST COMPLY WITH ADA WATER CLOSET MEASUREMENTS ON SHEET A-551
- DOOR AND WINDOWS OPENINGS ARE INDICATED WITH ANNOTATION SYMBOLS AND ARE FURTHER IDENTIFIED ON DOOR AND WINDOW SCHEDULES. SEE BOTH FLOOR PLANS AND EXTERIOR ELEVATIONS FOR ALL REFERENCES. DIMENSIONS TO FRAMES WILL BE TO OUTSIDE EDGE OF FRAME. CONTRACTOR SHALL CONFIRM ROUGH OPENING WITH MANUFACTURER.
- SUB-CONTRACTORS SHALL VERIFY ALL DIMENSIONS FOR THEIR WORK.
- SEE STRUCTURAL DRAWINGS FOR TOTAL VERTICAL DISPLACEMENT OF WOOD FRAMING DUE TO SHRINKAGE AND EXPANSION FOR HEIGHT OF BUILDING. CONSTRUCTION OF PLUMBING STACKS AND RISERS SHALL ACCOUNT FOR MOVEMENT OF FRAMING OVER TIME.
- WALL TYPES SHOWN AS $\text{---} \text{---} \text{---}$ S6A ARE SHOWN ON SHEET A-611. FOR EXTERIOR WALLS SEE BUILDING & WALL SECTIONS. FOR STANDARD STEEL STUD DETAILS SEE A-511 & A-512.

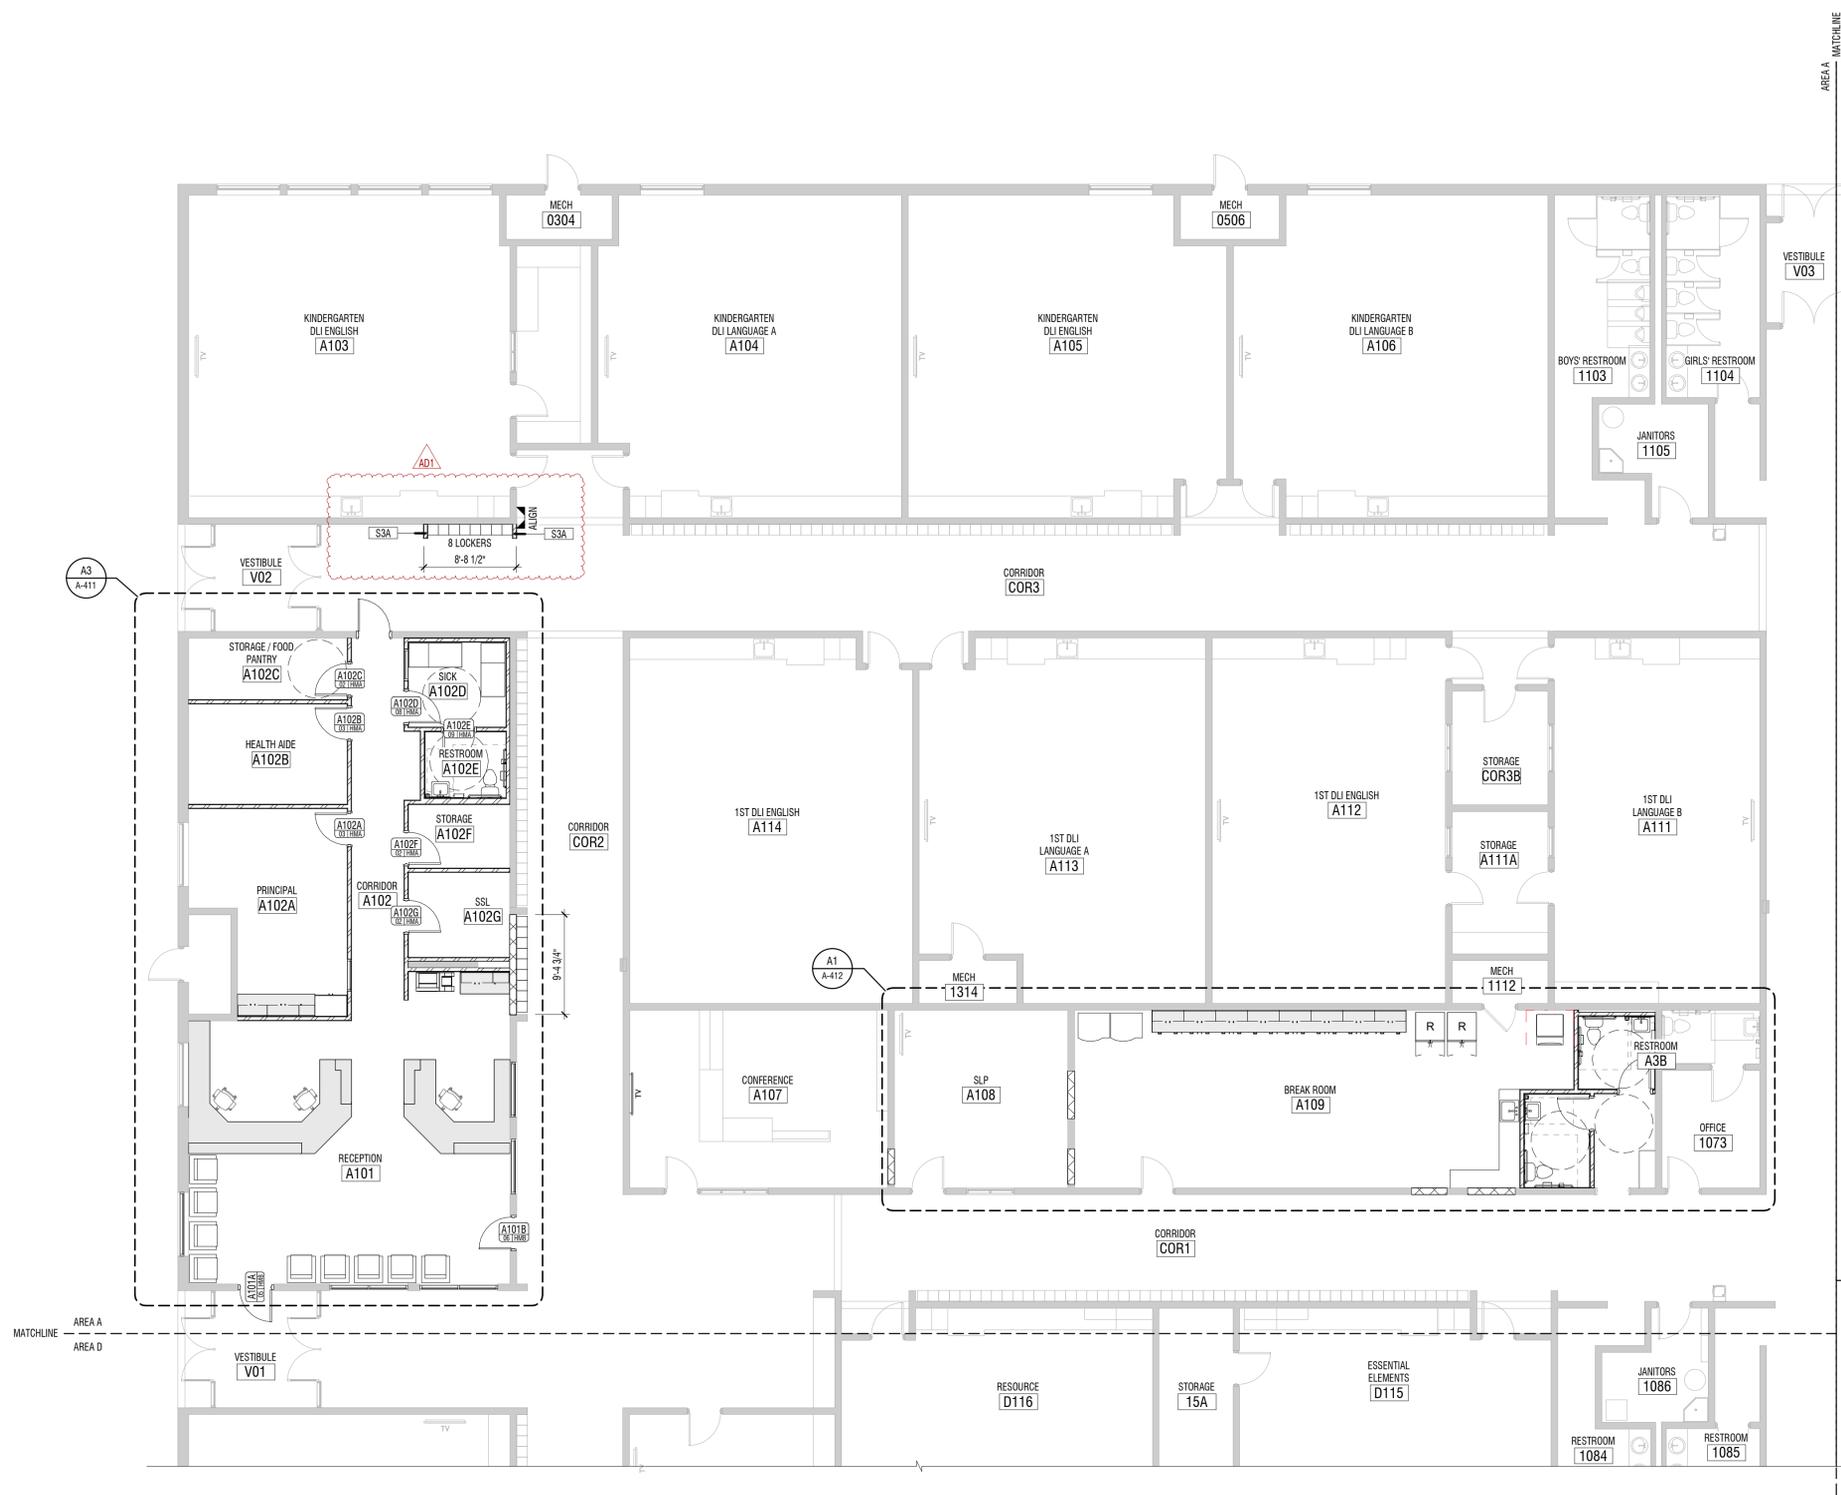

KEY PLAN - PHASE 2 - LEVEL 01

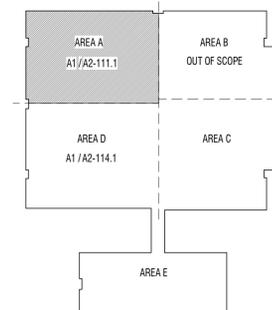

A1 PLAN - DIMENSIONS
1/8" = 1'-0" PHASE 2 - LEVEL 01 - AREA A



MARKS: 1

PROJECT #: 123008
DRAWN BY: HARRIS
CHECKED BY: WILLIAMS
ISSUED: 02.19.2026



PLAN - PHASE 2 - LEVEL 01 - AREA A - DIMENSION

A2-111.1

CONSTRUCTION DOCUMENTS



GENERAL NOTES

- KEYNOTES (#) THE FIRST TWO NUMBERS REPRESENT THE RELATED CSI MASTER FORMAT DIVISION. THE SECOND SET OF NUMBERS REPRESENTS AN IDENTIFYING MARK VALUE. NOT ALL VALUES MAY BE USED OR OCCUR IN THE DOCUMENT SET.
ADDITIONALLY, KEYNOTES RETAIN THEIR ASSIGNED VALUE UNIVERSALLY THROUGHOUT THE SET. THE KEYNOTES LISTED BELOW, REPRESENT THE KEYNOTES FOUND AND UTILIZED ON THIS SHEET AND EACH LIST WILL DIFFER RESPECTIVE TO ITS SHEET. THEREFORE, BASED ON ACTUAL KEYNOTES UTILIZED ON A GIVEN SHEET OF DRAWINGS, GAPS IN THE SEQUENCING WILL OCCUR.
- CONTRACTOR SHALL BE FAMILIARIZED WITH THE LAY-OUT OF STRUCTURAL, MECHANICAL, AND ELECTRICAL DRAWINGS. ANY QUESTIONS SHALL BE SUBMITTED VIA REQUEST FOR INFORMATION (RFI).
- DOOR AND WINDOWS OPENINGS ARE INDICATED WITH ANNOTATION SYMBOLS AND ARE FURTHER IDENTIFIED ON DOOR AND WINDOW SCHEDULES. SEE BOTH FLOOR PLANS AND EXTERIOR ELEVATIONS FOR ALL REFERENCES.
- PROVIDE CONTINUOUS WOOD BLOCKING OR METAL STRAPPING FOR ANY WALL MOUNTED OR SUPPORTED ITEMS. PROVIDE FIRE RATED BLOCKING FOR ANY FIRE RATED PARTITIONS PER A-511
- FEC = FIRE EXTINGUISHER IN SEMI-RECESSED CABINET.
- A1/A-101 INDICATES INTERIOR ROOM ELEVATIONS ON SHEET REFERENCED.
- SEE SHEET SERIES G-002 & A-612 FOR ALL FIRE WALLS, SMOKE WALLS, WALLS TO CEILING LEVEL, SOUND WALLS.
- SEE FINISH PLANS FOR SIGNAGE LOCATION, SIGNAGE SYMBOL.
- SEE SITE PLANS FOR EXTERIOR STAIRS, RAILING AND RAMP DETAILS.
- ROLLER SHADES PER FINISH PLANS.
- EXTEND ALL WALLS SURROUNDING AN OPEN CEILING AREA TO DECK.
- SLOPE ALL SETTING BEDS TO FLOOR DRAINS U.I.O.
- PROVIDE 5/8" PLYWOOD BACKING PANELS AT ELECTRICAL ROOMS AND TELEVISION LOCATIONS FOR EQUIPMENT MOUNTING. PAINT TO MATCH WALLS PER A-511
- BLOCKING TO BE PROVIDED AT SHELVING, CASEWORK, RAILINGS, LIGHT FIXTURE, COUNTERTOP, ACCESSORIES AND MORE PER A-511, TYP

KEYNOTES

MARK	DESCRIPTION
06.01	NEW LOWERED COUNTER TO BE 34" A.F.F.
10.02	RELOCATED TWO TIER LOCKERS


KEY PLAN - PHASE 2 - LEVEL 01

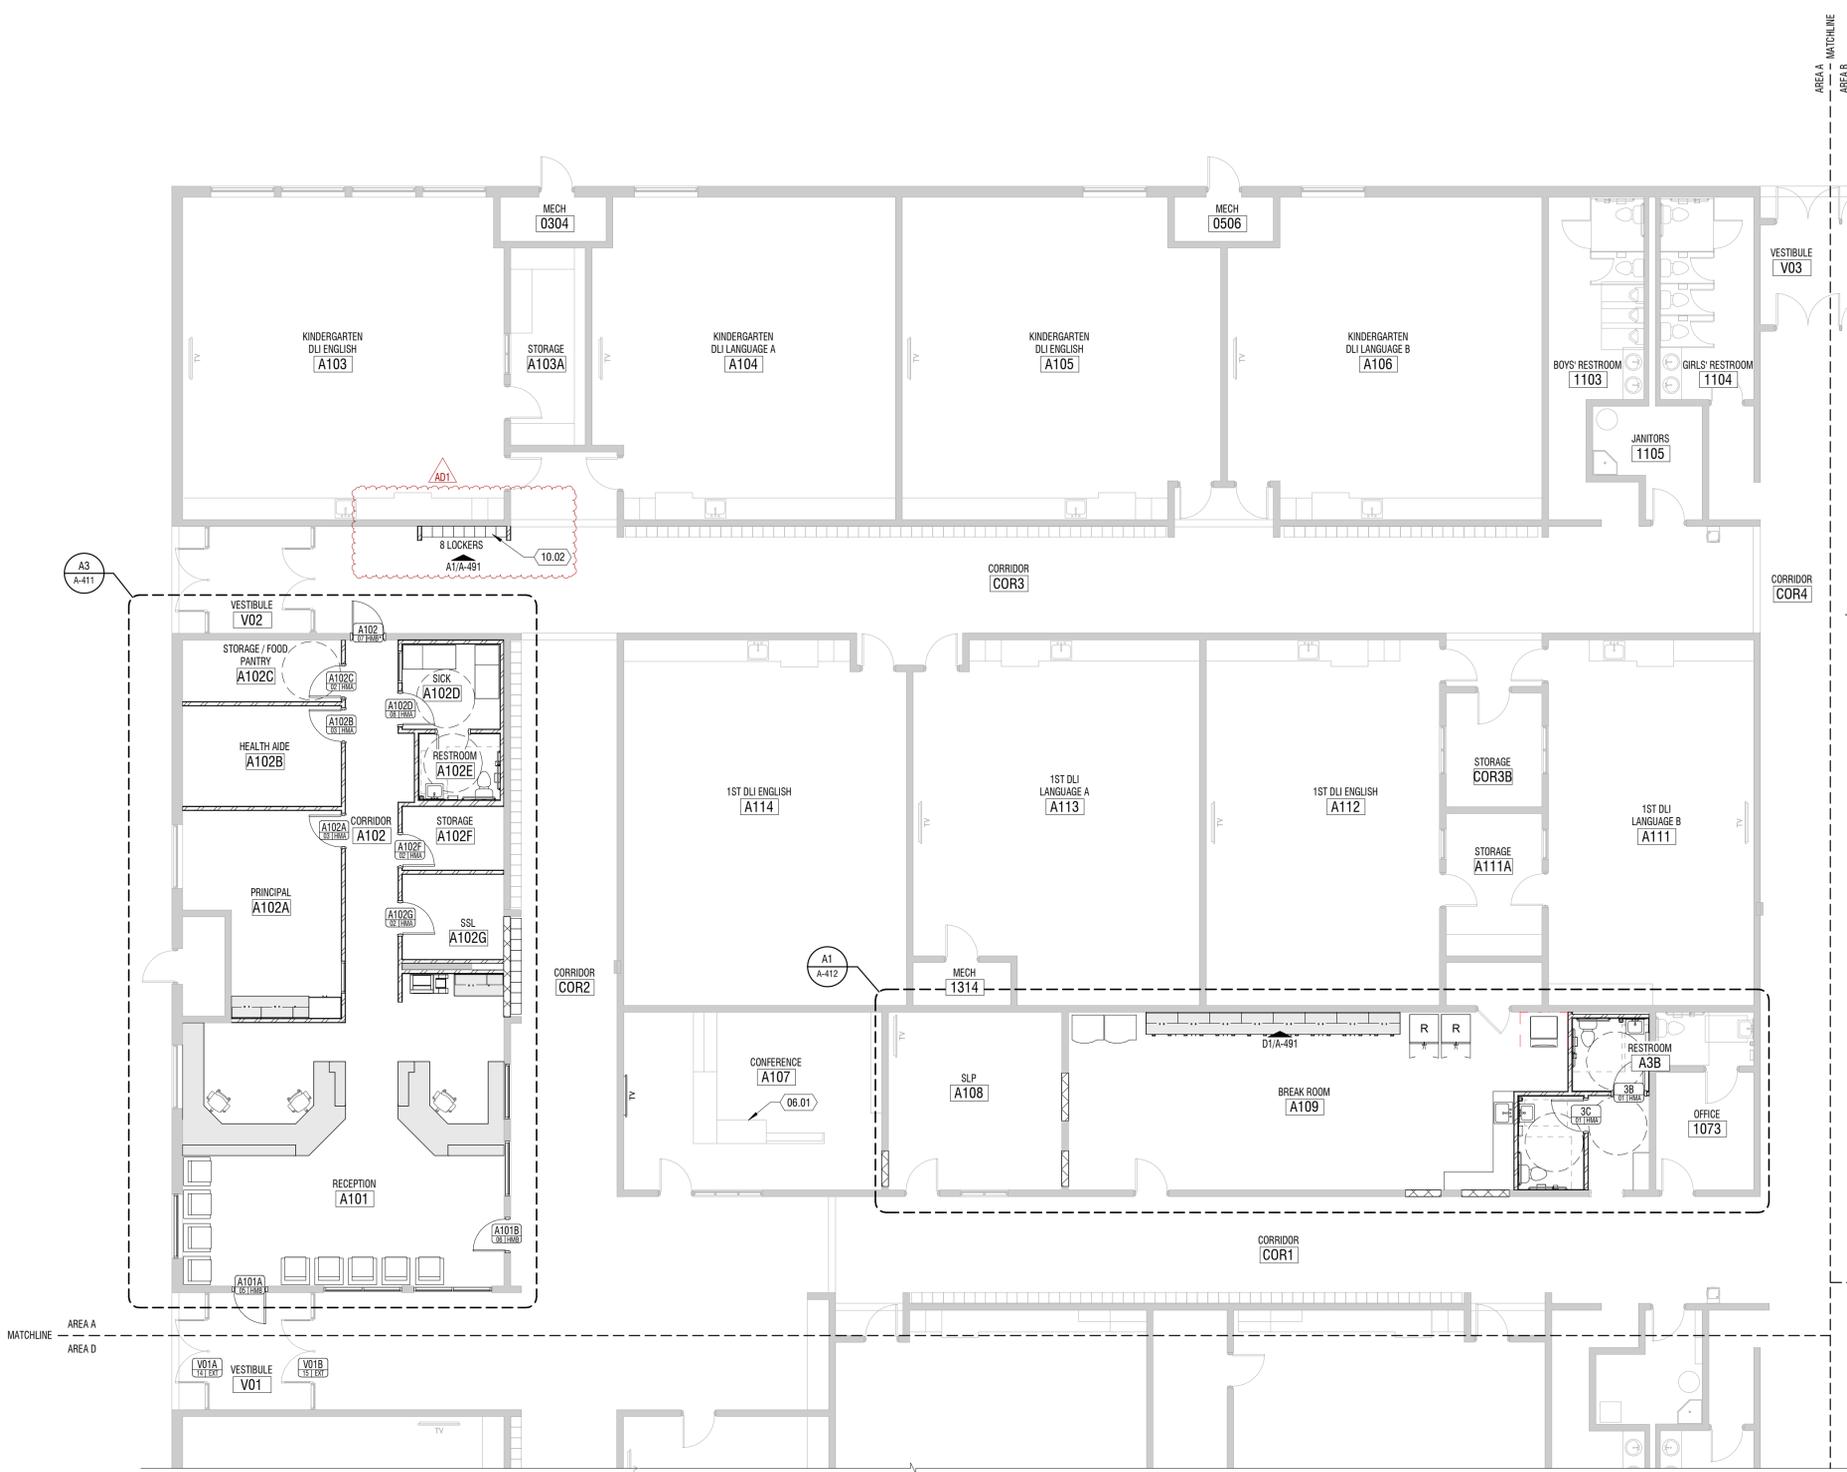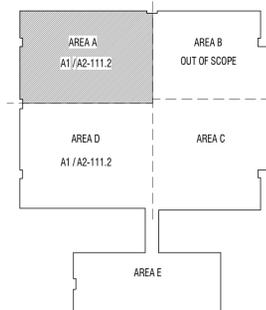


A1 PLAN - ANNOTATION
1/8" = 1'-0" PHASE 2 - LEVEL 01 - AREA A

GENERAL NOTES

1. CONTRACTOR SHALL BE FAMILIARIZED WITH THE LAY-OUT OF STRUCTURAL, MECHANICAL, AND ELECTRICAL DRAWINGS. ANY QUESTIONS SHALL BE SUBMITTED VIA REQUEST FOR INFORMATION (RFI).
2. ALL INTERIOR DIMENSIONS ARE TO FROM FACE OF STUD / MASONRY. ALL EXTERIOR DIMENSIONS ARE TO FROM FACE OF GRID/FOUNDATION. DIMENSIONS MARKED 'CLEAR' OR 'CLR' ARE FROM FACE OF FINISH TO FACE OF FINISH AND SHALL BE MAINTAINED AND CANNOT BE FIELD ADJUSTED WITHOUT PRIOR APPROVAL OF THE ARCHITECT.
3. MIN CLEARANCE REQUIRED ON LATCH SIDE OF DOORS SHALL CONFORM TO ADA REQUIREMENTS
4. HINGE SIDE OF DOORS AT PERPENDICULAR WALLS TO HAVE 3" STUD SECTION U.N.O
5. ALIGN FURRED WALLS AND STUD WALL FINISH FACE TYPICAL. U.N.O.
6. ADA RESTROOMS MUST COMPLY WITH ADA. WATER CLOSET MEASUREMENTS ON SHEET A-551
7. DOOR AND WINDOWS OPENINGS ARE INDICATED WITH ANNOTATION SYMBOLS AND ARE FURTHER IDENTIFIED ON DOOR AND WINDOW SCHEDULES. SEE BOTH FLOOR PLANS AND EXTERIOR ELEVATIONS FOR ALL REFERENCES. DIMENSIONS TO FRAMES WILL BE TO OUTSIDE EDGE OF FRAME. CONTRACTOR SHALL CONFIRM ROUGH OPENING WITH MANUFACTURER.
8. SUB-CONTRACTORS SHALL VERIFY ALL DIMENSIONS FOR THEIR WORK.
9. SEE STRUCTURAL DRAWINGS FOR TOTAL VERTICAL DISPLACEMENT OF WOOD FRAMING DUE TO SHRINKAGE AND EXPANSION FOR HEIGHT OF BUILDING. CONSTRUCTION OF PLUMBING STACKS AND RISERS SHALL ACCOUNT FOR MOVEMENT OF FRAMING OVER TIME.
10. WALL TYPES SHOWN AS ARE SHOWN ON SHEET A-611. FOR EXTERIOR WALLS SEE BUILDING & WALL SECTIONS. FOR STANDARD STEEL STUD DETAILS SEE A-511 & A-512.

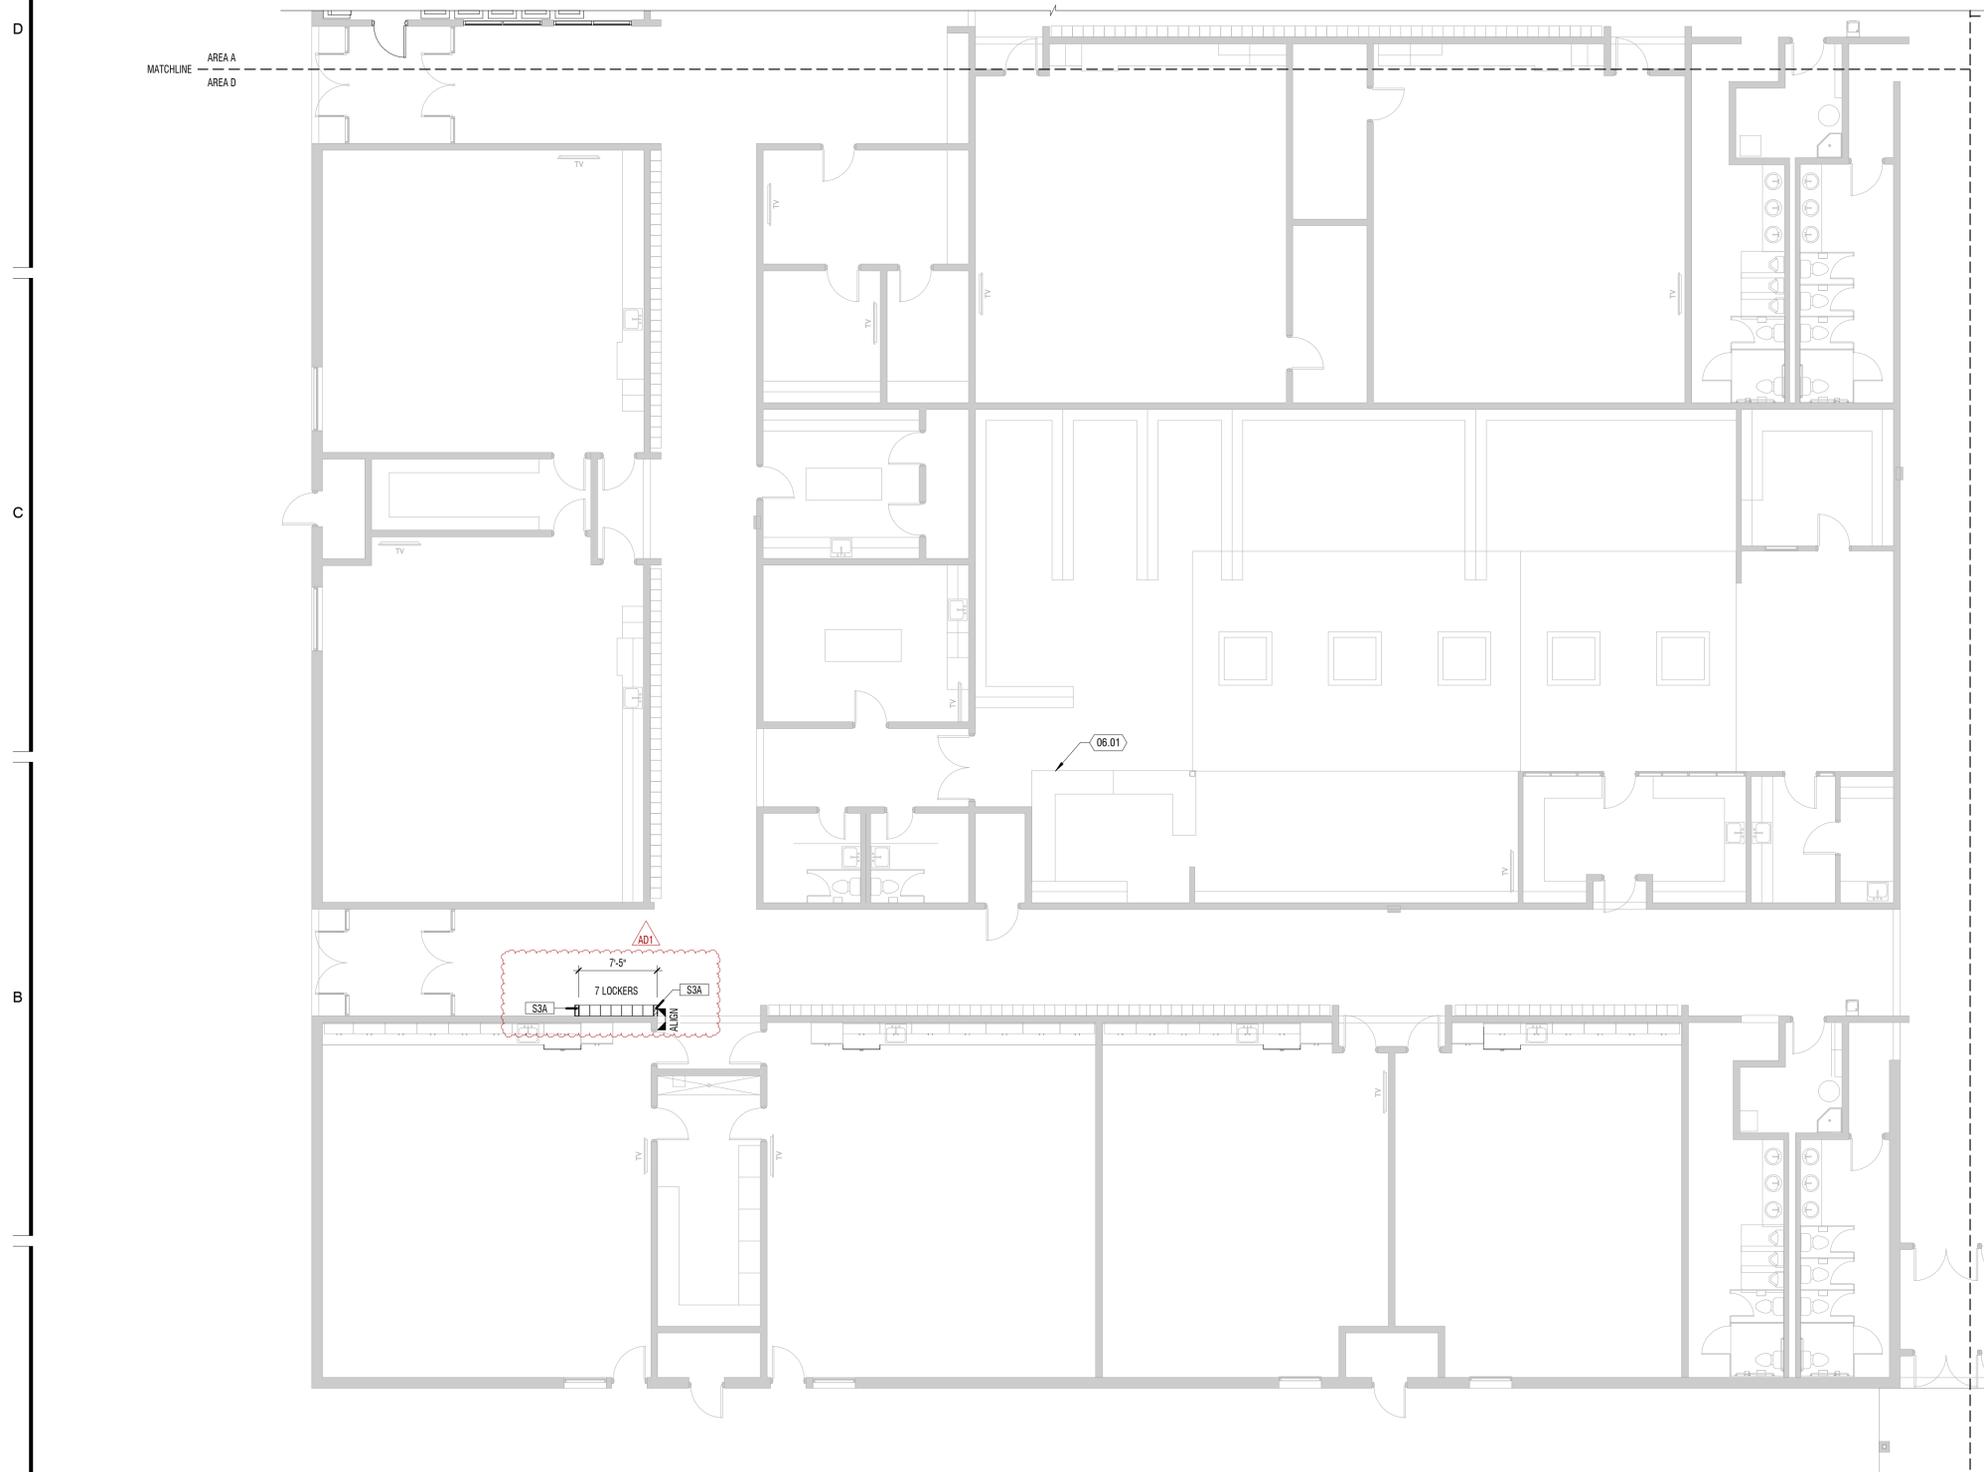

KEY PLAN - PHASE 2 - LEVEL 01

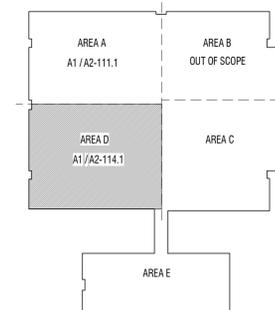

A1 PLAN - DIMENSION
 1/8" = 1'-0"
 AREA D - LEVEL 01

MARKS	DESCRIPTION:	ADDITIONUM 01
DATE:	02.19.2026	
PROJECT #:	123008	
DRAWN BY:	HARRIS	
CHECKED BY:	WILLIAMS	
ISSUED:	02.19.2026	



PLAN - PHASE 2 - LEVEL 01 - AREA D - DIMENSION

A2-114.1

CONSTRUCTION DOCUMENTS


GENERAL NOTES

- KEYNOTES (#) THE FIRST TWO NUMBERS REPRESENT THE RELATED CSI MASTER FORMAT DIVISION. THE SECOND SET OF NUMBERS REPRESENTS AN IDENTIFYING MARK VALUE. NOT ALL VALUES MAY BE USED OR OCCUR IN THE DOCUMENT SET.
ADDITIONALLY, KEYNOTES RETAIN THEIR ASSIGNED VALUE UNIVERSALLY THROUGHOUT THE SET. THE KEYNOTES LISTED BELOW, REPRESENT THE KEYNOTES FOUND AND UTILIZED ON THIS SHEET AND EACH LIST WILL DIFFER RESPECTIVE TO ITS SHEET. THEREFORE, BASED ON ACTUAL KEYNOTES UTILIZED ON A GIVEN SHEET OF DRAWINGS, GAPS IN THE SEQUENCING WILL OCCUR.
- CONTRACTOR SHALL BE FAMILIARIZED WITH THE LAY-OUT OF STRUCTURAL, MECHANICAL, AND ELECTRICAL DRAWINGS. ANY QUESTIONS SHALL BE SUBMITTED VIA REQUEST FOR INFORMATION (RFI).
- DOOR AND WINDOW OPENINGS ARE INDICATED WITH ANNOTATION SYMBOLS AND ARE FURTHER IDENTIFIED ON DOOR AND WINDOW SCHEDULES. SEE BOTH FLOOR PLANS AND EXTERIOR ELEVATIONS FOR ALL REFERENCES.
- PROVIDE CONTINUOUS WOOD BLOCKING OR METAL STRAPPING FOR ANY WALL MOUNTED OR SUPPORTED ITEMS. PROVIDE FIRE RATED BLOCKING FOR ANY FIRE RATED PARTITIONS PER A-511
- FEC = FIRE EXTINGUISHER IN SEMI-RECESSED CABINET.
- A1/A-101 INDICATES INTERIOR ROOM ELEVATIONS ON SHEET REFERENCED.
- SEE SHEET SERIES G-002 & A-612 FOR ALL FIRE WALLS, SMOKE WALLS, WALLS TO CEILING LEVEL, SOUND WALLS.
- SEE FINISH PLANS FOR SIGNAGE LOCATION, SIGNAGE SYMBOL.
- SEE SITE PLANS FOR EXTERIOR STAIRS, RAILING AND RAMP DETAILS.
- ROLLER SHADES PER FINISH PLANS.
- EXTEND ALL WALLS SURROUNDING AN OPEN CEILING AREA TO DECK.
- SLOPE ALL SETTING BEDS TO FLOOR DRAINS U.N.O.
- PROVIDE 5/8" PLYWOOD BACKING PANELS AT ELECTRICAL ROOMS AND TELEVISION LOCATIONS FOR EQUIPMENT MOUNTING. PAINT TO MATCH WALLS PER A-511
- BLOCKING TO BE PROVIDED AT SHELVING, CASEWORK, RAILINGS, LIGHT FIXTURE, COUNTERTOP, ACCESSORIES AND MORE PER A-511, TYP

KEYNOTES

#	DESCRIPTION
MARK	
10.02	RELOCATED TWO TIER LOCKERS

KEY PLAN - PHASE 2 - LEVEL 01

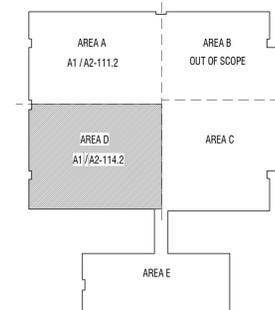


MARKS	1
DATE	02.19.2026
DESCRIPTION	ADDENDUM 01
PROJECT #	123008
DRAWN BY	HARRIS
CHECKED BY	WILLIAMS
ISSUED	02.19.2026



PLAN - PHASE 2 - LEVEL 01 - AREA D - ANNOTATION

A2-114.2

CONSTRUCTION DOCUMENTS

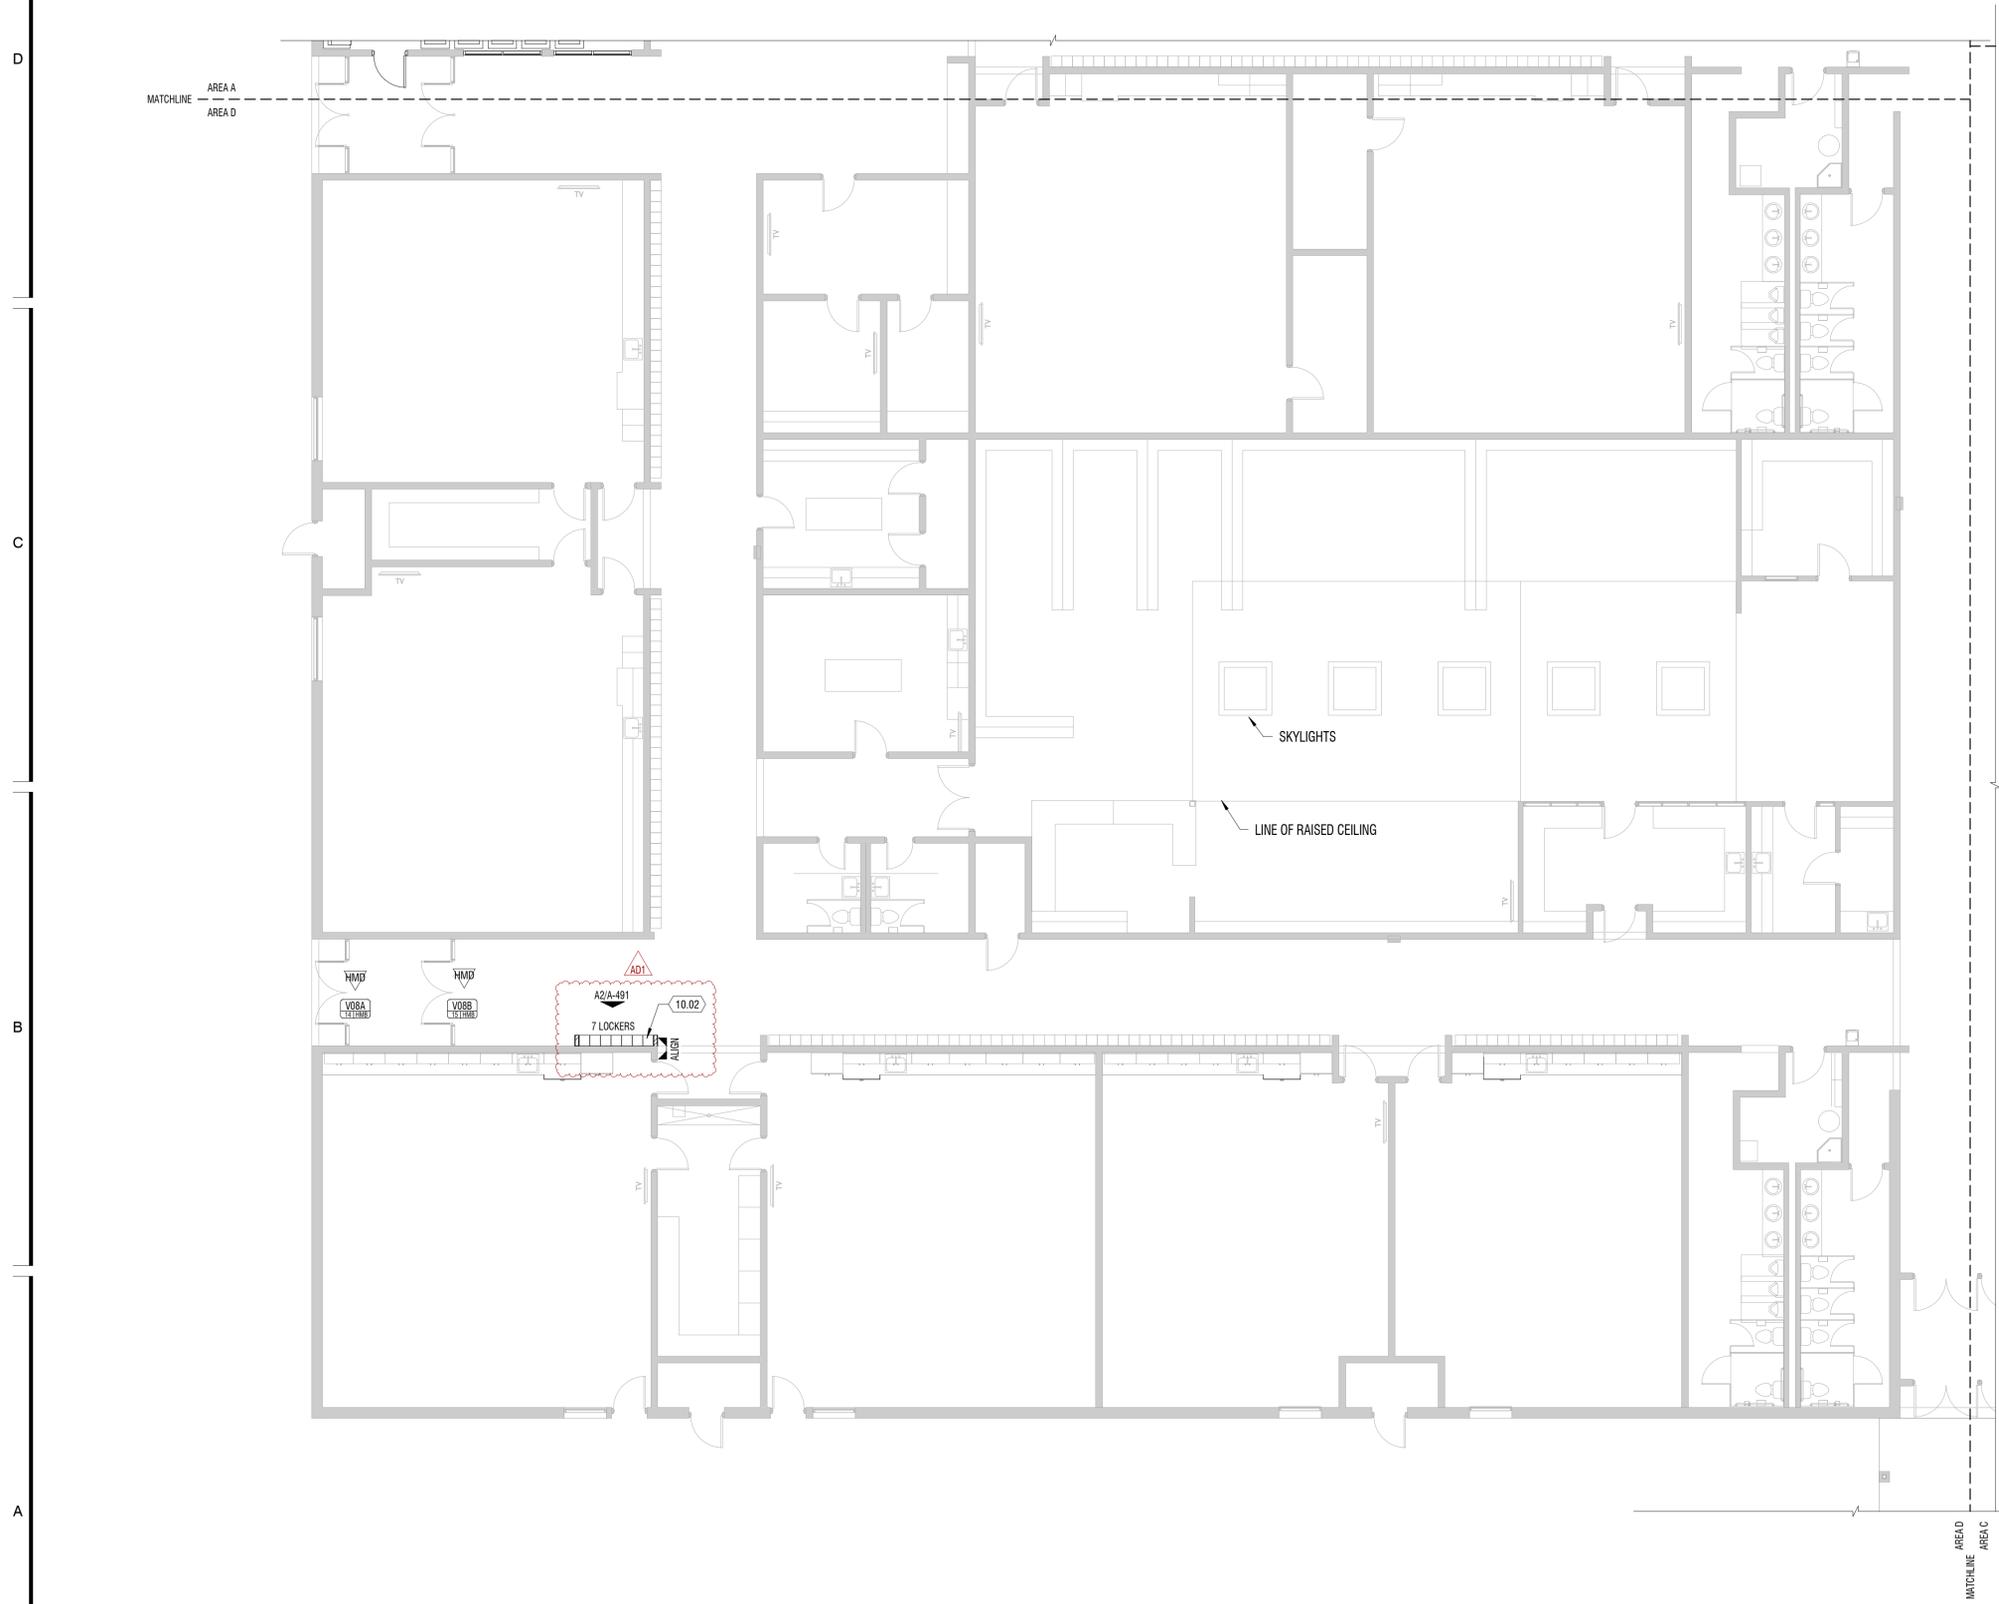

A1 PLAN - ANNOTATION
1/8" = 1'-0"
AREA D - LEVEL 01



MARKS	DATE: 02.19.2026	PROJECT #: 123008
	DESCRIPTION: ADDENDUM 01	DRAWN BY: HARRIS
		CHECKED BY: WILLIAMS
		ISSUED: 02.19.2026



GENERAL NOTES

- KEYNOTES: THE FIRST TWO NUMBERS REPRESENT THE RELATED CSI MASTERFORMAT DIVISION. THE SECOND SET OF NUMBERS REPRESENTS AN IDENTIFYING MARK VALUE. NOT ALL VALUES MAY BE USED OR OCCUR IN THE DOCUMENT SET.
 ADDITIONALLY, KEYNOTES RETAIN THEIR ASSIGNED VALUE UNIVERSALLY THROUGHOUT THE SET. THE KEYNOTES LISTED BELOW, REPRESENT THE KEYNOTES FOUND AND UTILIZED ON THIS SHEET AND EACH LIST WILL DIFFER RESPECTIVE TO ITS SHEET. THEREFORE, BASED ON ACTUAL KEYNOTES UTILIZED ON A GIVEN SHEET OF DRAWINGS, GAPS IN THE SEQUENCING WILL OCCUR.
- CONTRACTOR SHALL VERIFY LAY-OUT OF STRUCTURAL, MECHANICAL, AND ELECTRICAL.
- ALL INTERIOR DIMENSIONS ARE TO/FROM FACE OF STUD / MASONRY. ALL EXTERIOR DIMENSIONS ARE TO/FROM FACE OF GRID/FOUNDATION. DIMENSIONS MARKED "CLEAR" OR "CLR" ARE FROM FACE OF FINISH TO FACE OF FINISH AND SHALL BE MAINTAINED AND CANNOT BE FIELD ADJUSTED WITHOUT PRIOR APPROVAL OF THE ARCHITECT.

KEYNOTES


#	DESCRIPTION
04.01	TOOTH IN MASONRY TO MATCH EXISTING
10.04	ICE MACHINE - OWNER PROVIDED, CONTRACTOR INSTALLED
10.05	REFRIGERATOR - OWNER PROVIDED, CONTRACTOR INSTALLED
10.06	VENDING MACHINE - OWNER PROVIDED, CONTRACTOR INSTALLED
22.01	SINK

ACCESSORIES

- (A) TOILET TISSUE DISPENSER
OWNER FURNISHED, CONTRACTOR INSTALLED
- (B) GRAB BAR
LENGTH INDICATED ON PLAN
- (C) PAPER TOWEL DISPENSER
OWNER FURNISHED, CONTRACTOR INSTALLED
- (D) MIRROR
SIZE INDICATED ON PLAN
- (E) UNDER-COUNTER SOAP DISPENSER
OWNER FURNISHED, CONTRACTOR INSTALLED
- (F) FEMININE NAPKIN VENDOR
- (G) FEMININE NAPKIN DISPOSAL
- (H) MOP & BROOM HOLDER
LENGTH INDICATED ON PLANS
- (J) DIAPER CHANGING STATION
- (K) DRAIN PIPE PROTECTION


LEGEND

CEILING	MILLWORK	ROOM FINISH TAG
FLOOR	BASE	* = SEE ELEVATIONS FOR FINISH SELECTIONS
WALL	WALL	- = NO FINISH APPLIED
WALL	WALL	
	C1	FINISH TAG - INDICATES SPECIFIC APPLIED FINISH
	C1	INDICATES FINISH IS APPLIED TO AREA BETWEEN ARROWS
	C1	INDICATES FINISH IS APPLIED TO FACE OF SURFACE(S)
	CG	INDICATES SIGNAGE LOCATION
AD1	CG	INDICATES CORNER GUARD - SEE M11 ON FINISH SCHEDULE
RS		INDICATES A MANUAL ROLLER SHADE

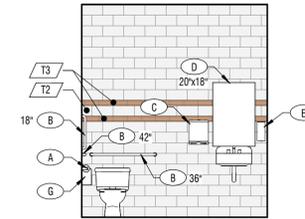


D4 ELEVATION

1/4" = 1'-0" PHASE 2 - AREA A - RESTROOM 3C

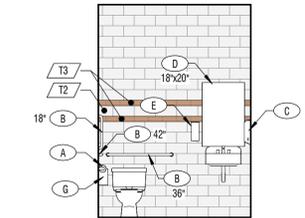


C4 ELEVATION

1/4" = 1'-0" PHASE 2 - AREA A - RESTROOM 3B

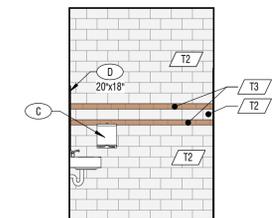

B4 ELEVATION

1/4" = 1'-0" PHASE 2 - AREA A - RESTROOM 3B

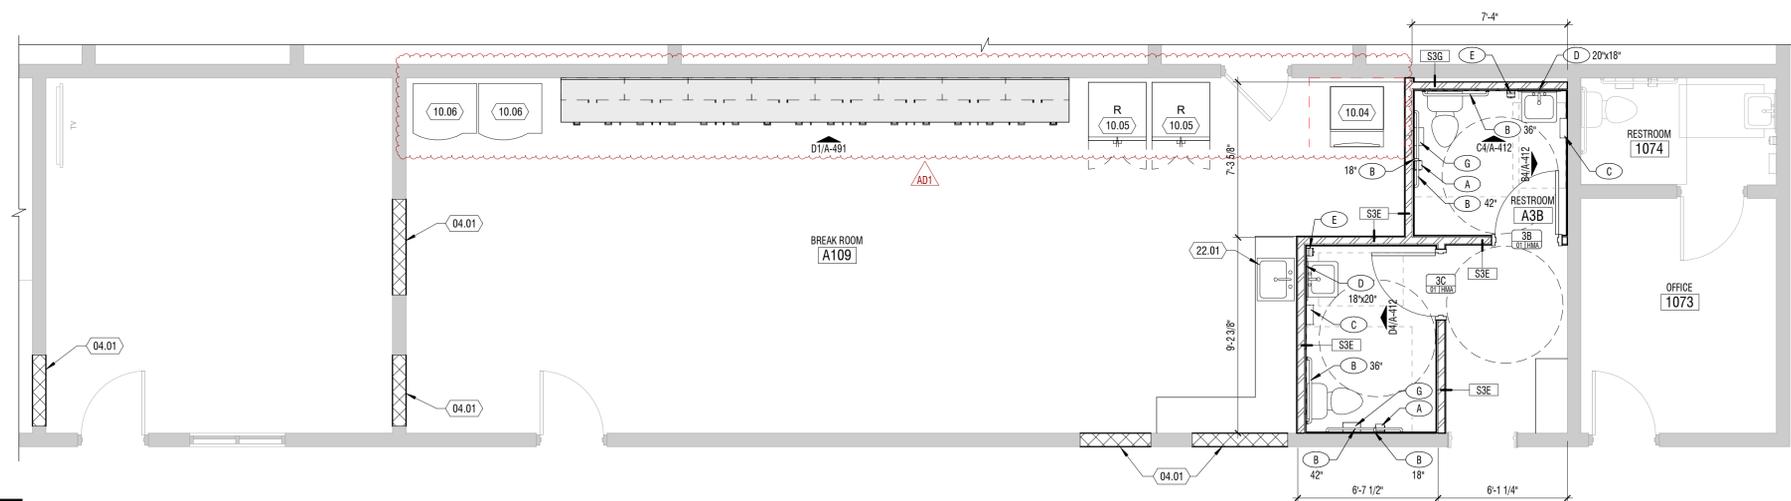

A1 ENLARGED PLAN

1/4" = 1'-0" AREA A - LEVEL 01

CONSTRUCTION DOCUMENTS

CASEWORK KEY

CABINET TYPE
 D DRAWER(S)
 W WALL CABINET
 T TALL CABINET
 SB SINK BASE CABINET
 MB MICROWAVE BASE CABINET

NOTES:
 CABINET TYPE
 D BASE CABINET
 W WALL CABINET
 T TALL CABINET
 SB SINK BASE CABINET
 MB MICROWAVE BASE CABINET

DRAWER
 # DENOTES NUMBER OF TOTAL DRAWERS

DOOR
 # DENOTES NUMBER OF TOTAL DOORS

ADJUSTABLE SHELVES
 # DENOTES NUMBER OF TOTAL SHELVES

ACCESSORY
 L LOCKS AT DOOR(S)/DRAWER(S)
 F FILE DRAWER(S)
 V VENTED DOOR
 R REV-A-SHELF OR EQUAL GARBAGE PULLOUT DRAWER
 - DENOTES NO ACCESSORY

CASEWORK TAG
 18W24D → SIZE
 B111- → IDENTIFIER
 A1/A-591 → DETAIL REFERENCE

HARDWARE
 CABINET PULLS - *****


TOE KICK DIMENSIONS
 STANDARD 4" U.N.O.

CASEWORK GENERAL NOTES


- SEE FINISH SCHEDULE FOR MATERIAL.

KEYNOTES


MARK	DESCRIPTION
10.01	WHITEBOARD WITH HIDDEN TACKLESS PAPER HOLDER ON TOP AND MARKER TRAY ON BOTTOM
10.02	RELOCATED TWO TIER LOCKERS
10.03	ONE TIER LOCKER W/ COUNTER TOP
10.04	ICE MACHINE - OWNER PROVIDED, CONTRACTOR INSTALLED
10.05	REFRIGERATOR - OWNER PROVIDED, CONTRACTOR INSTALLED
10.06	VENDING MACHINE - OWNER PROVIDED, CONTRACTOR INSTALLED
11.01	WALL MOUNTED DIGITAL DISPLAY - SEE DETAIL A-591/CS FOR MOUNTING. OWNER PROVIDED, CONTRACTOR INSTALLED
22.01	SINK

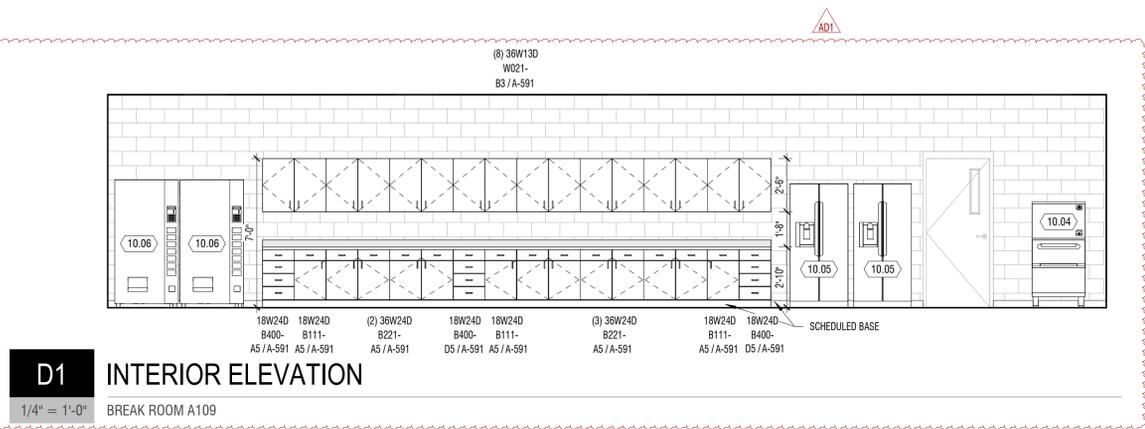


D1 INTERIOR ELEVATION
 1/4" = 1'-0" BREAK ROOM A109

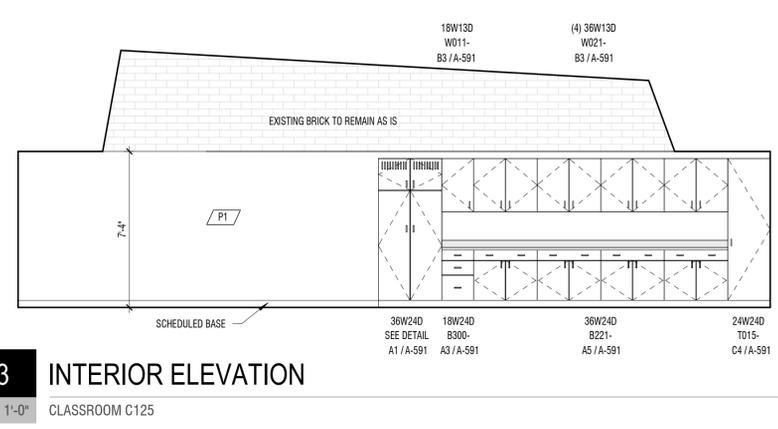


D3 INTERIOR ELEVATION
 1/4" = 1'-0" CLASSROOM C125

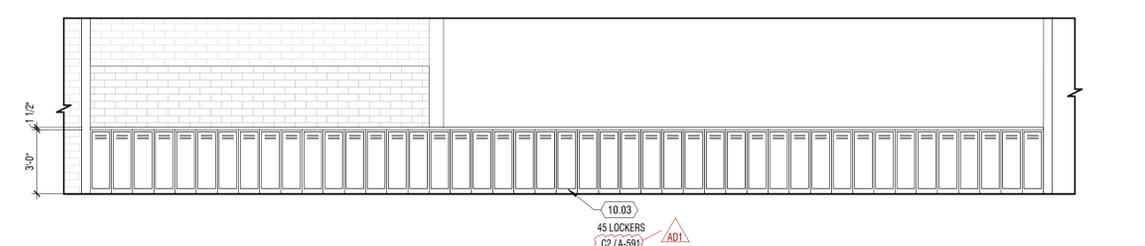


C1 INTERIOR ELEVATION
 1/4" = 1'-0" CORRIDOR C

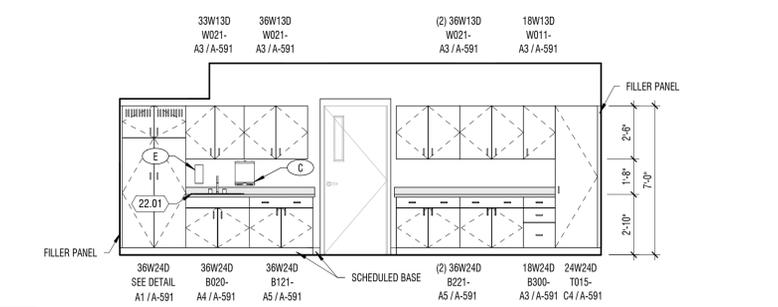

C3 INTERIOR ELEVATION
 1/4" = 1'-0" PHASE 1 - CLASSROOM E129

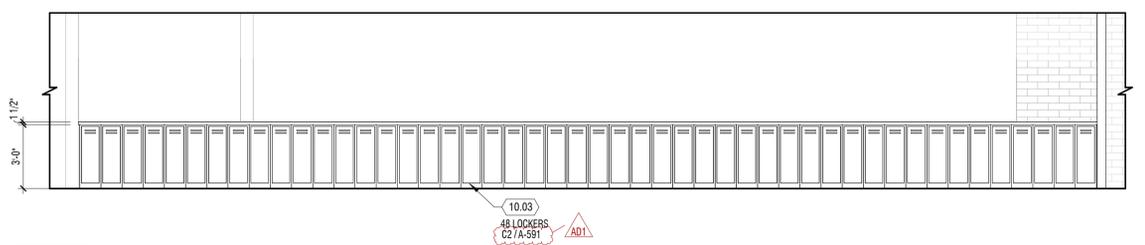

B1 INTERIOR ELEVATION
 1/4" = 1'-0" CORRIDOR C

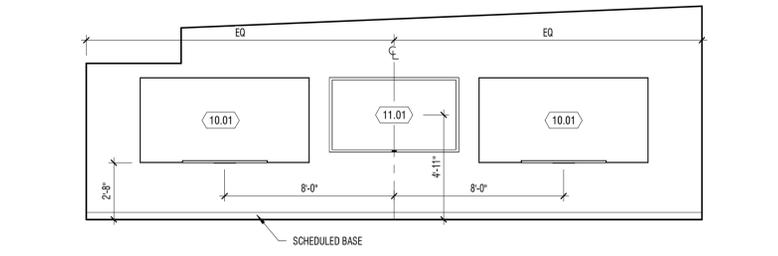


B3 INTERIOR ELEVATION
 1/4" = 1'-0" TYPICAL TEACHING WALL



A1 INTERIOR ELEVATION
 1/4" = 1'-0" CORRIDOR C03

A2 INTERIOR ELEVATION
 1/4" = 1'-0" CORRIDOR C08

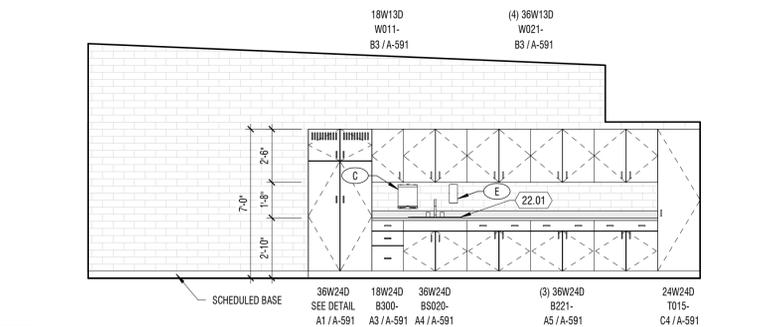

A3 INTERIOR ELEVATION
 1/4" = 1'-0" CLASSROOM E127


CONSTRUCTION DOCUMENTS

MARK	DESCRIPTION	ADENDUM 01
DATE	02.19.2026	
PROJECT #	123008	
DRAWN BY	Author	
CHECKED BY	Checker	
ISSUED	02.19.2026	




ELEVATIONS - INTERIOR


A-491

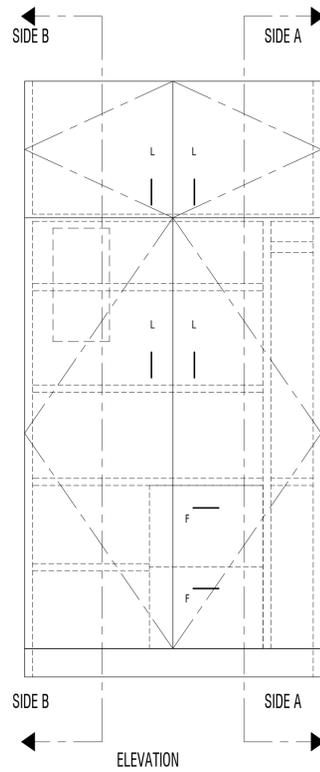


A1 TEACHER CABINET
1" = 1'-0"

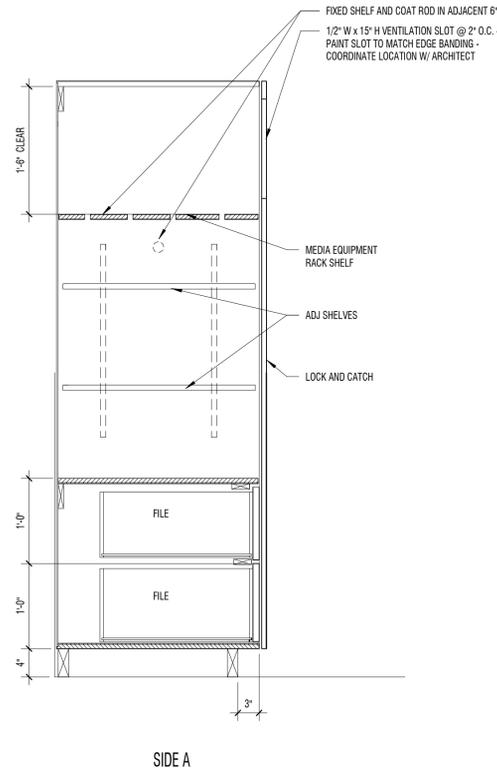


A3 BASE CABINET/ 3-DRAWER
1" = 1'-0"

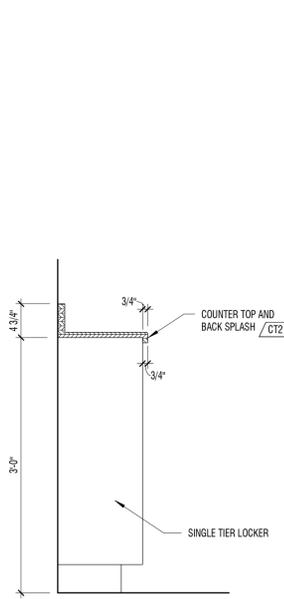



C2 LOCKER W/ COUNTERTOP
1" = 1'-0"

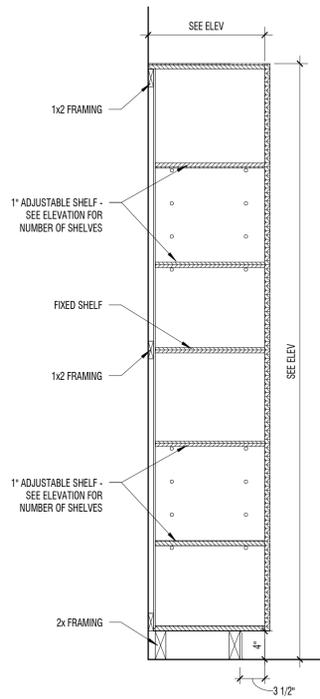


C4 TALL CABINET
1" = 1'-0"

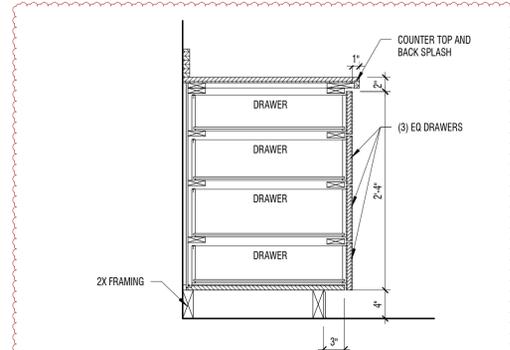


D5 FOUR DRAWER BASE
1" = 1'-0"

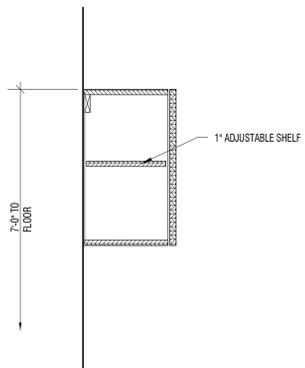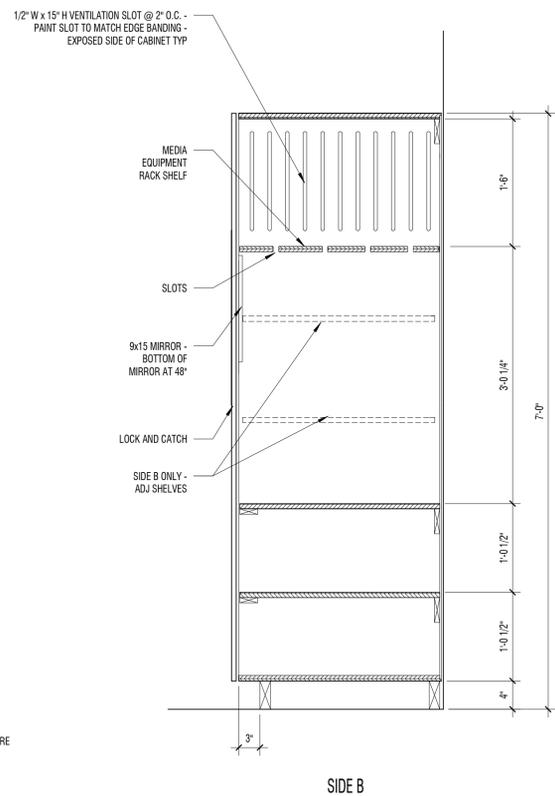

B3 UPPER CABINET
1" = 1'-0"

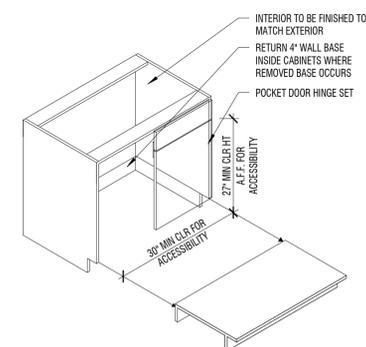


B4 ADA REMOVEABLE BASE
1/2" = 1'-0"

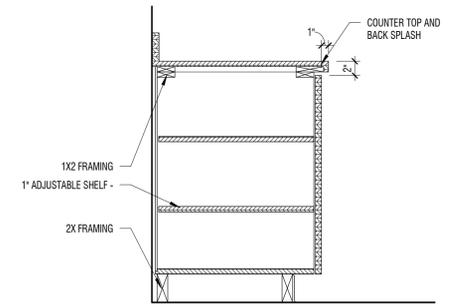


C5 BLOCKING AT TV YOKE
1" = 1'-0"


B5 BASE CABINET
1" = 1'-0"

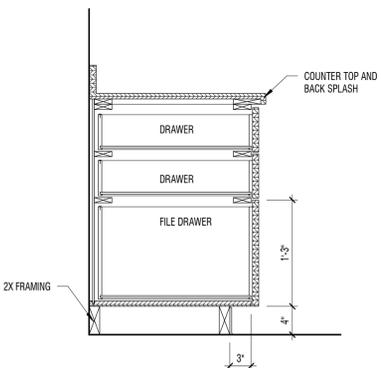

A4 SINK BASE
1" = 1'-0"

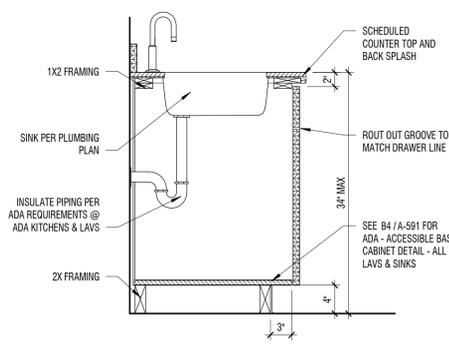

A5 BASE CABINET W/ DRAWER
1" = 1'-0"

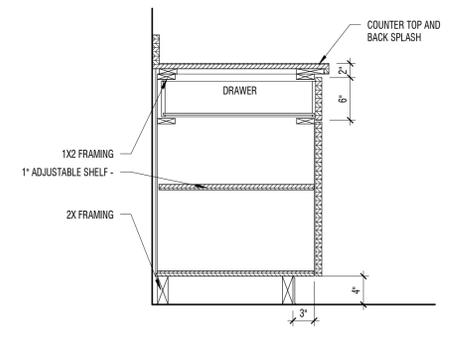

P-LAM OF FACEFRAME TO BE SELECTED FROM P-LAM MANUFACTURER'S RANGE OF COLORS - TO BE COORDINATED BY ARCHITECT
SEE PLANS AND INTERIOR ELEVATIONS TO COORDINATE - SIDE A AND SIDE B CAN BE OPPOSITE WHAT IS SHOWN HERE


DESCRIPTION:	ADDENDUM 01
DATE:	02.19.2026
PROJECT #:	123008
DRAWN BY:	Author
CHECKED BY:	Checker
ISSUED:	02.19.2026



SIGNAGE GRAPHICS

TYPE A


MATERIAL
ACRYLIC WITH RAISED TEXT & CHANGEABLE INSERTS

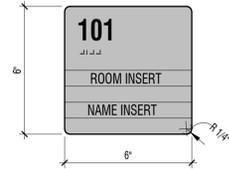

NOTES
TEXT HEIGHT: 5/8"
TEXT FONT: FUTURA
TEXT COLOR: BY ARCHITECT
BASE COLOR: BY ARCHITECT

TYPE G


MATERIAL
ACRYLIC WITH RAISED TEXT & PICTURE

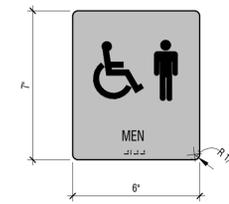

NOTES
TEXT HEIGHT: 5/8"
TEXT FONT: FUTURA
TEXT COLOR: BY ARCHITECT
BASE COLOR: BY ARCHITECT

TYPE B

MATERIAL
ACRYLIC WITH RAISED TEXT & CHANGEABLE INSERT

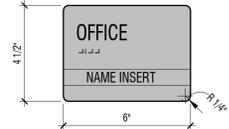

NOTES
TEXT HEIGHT: 5/8"
TEXT FONT: FUTURA
TEXT COLOR: BY ARCHITECT
BASE COLOR: BY ARCHITECT

TYPE H


MATERIAL
ACRYLIC WITH RAISED TEXT & PICTURE



NOTES
TEXT HEIGHT: 5/8"
TEXT FONT: FUTURA
TEXT COLOR: BY ARCHITECT
BASE COLOR: BY ARCHITECT

TYPE C

MATERIAL
ACRYLIC WITH RAISED TEXT

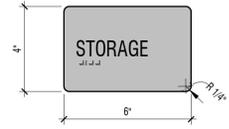

NOTES
TEXT HEIGHT: 5/8"
TEXT FONT: FUTURA
TEXT COLOR: BY ARCHITECT
BASE COLOR: BY ARCHITECT

TYPE J


MATERIAL
VINYL LETTERS - SEE SCHEDULE FOR TEXT



NOTES
TEXT HEIGHT: 1"
TEXT FONT: FUTURA
TEXT COLOR: BY ARCHITECT
BASE COLOR: BY ARCHITECT

TYPE D


MATERIAL
ACRYLIC WITH RAISED TEXT

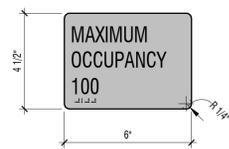

NOTES
TEXT HEIGHT: 5/8"
TEXT FONT: FUTURA
TEXT COLOR: BY ARCHITECT
BASE COLOR: BY ARCHITECT

TYPE K

MATERIAL
ALUMINUM CHANNEL LETTERS - SEE SCHEDULE FOR TEXT

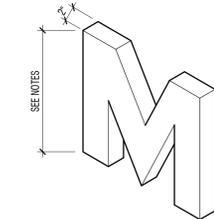

NOTES
TEXT HEIGHT: 12"
TEXT FONT: ARIAL
MATERIAL COLOR: T8D

TYPE E

MATERIAL
ACRYLIC WITH RAISED TEXT & PICTURE




NOTES
TEXT HEIGHT: 5/8"
TEXT FONT: FUTURA
TEXT COLOR: BY ARCHITECT
BASE COLOR: BY ARCHITECT

TO READ "FACULTY" AT ALL FACULTY RESTROOMS

TYPE F

MATERIAL
ACRYLIC WITH RAISED TEXT & PICTURE

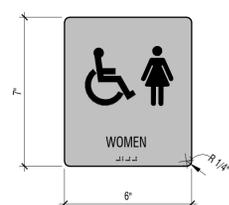

NOTES
TEXT HEIGHT: 5/8"
TEXT FONT: FUTURA
TEXT COLOR: BY ARCHITECT
BASE COLOR: BY ARCHITECT

GENERAL NOTES

- SEE FINISH PLANS FOR SIGNAGE LOCATIONS. SIGNAGE INDICATED WITH SYMBOL ON PLAN
- NUMBER REFERS TO SIGNAGE SCHEDULE. LETTER IN SCHEDULE REFERS TO SIGNAGE GRAPHICS
- MAINTAIN MIN 1/2" EDGE DISTANCE FROM ALL COPY/IMAGES
- FINAL SIGN TEXT TO BE APPROVED BY OWNER AND ARCHITECT
- PROVIDE ALL SIGNAGE REQUIRED BY CODE AND COMPLY WITH ANSI SECTION 703
- FINAL COPY AND LAY OUT OF SIGNAGE TO BE COORDINATED W/ ARCHITECT. SIZES AND MATERIALS, ESTABLISHED COPY TO BE DETERMINED BY OWNER AND SUPPLIED FOR SHOP DRAWINGS
- WHEN SIGN IS MOUNTED ON GLASS, PROVIDE BLANK BACKER PLATE THAT MATCHES SIZE AND STYLE ON OTHER SIDE OF GLASS

SIGNAGE SCHEDULE

MARK	SIGNAGE TYPE	REQUIRED TEXT
1	J	AD1 ALL VISITORS ARE REQUIRED TO CHECK IN AT THE MAIN ENTRANCE OFFICE
2	C	EXIT
3	A	CLASSROOM
4	C	STORAGE
6	C	JANITOR
9	C	ELECTRICAL
10	C	RESOURCE
11	F	WOMEN
12	G	MEN
13	E	RESTROOM
14	B	OFFICE
15	C	BREAK ROOM
16	A	SLP
17	C	CONFERENCE
18	C	ADMINISTRATION SUITE
19	A	SSL
20	B	PRINCIPAL
21	C	HEALTH AIDE
22	C	STORAGE/ FOOD PANTRY
23	C	SICK
24	B	COUNSELOR
25	C	GROUP
26	C	MEDIA CENTER
27	C	MEDIA ROOM
28	C	FACULTY WORK ROOM
29	C	GYMNASIUM
30	C	PE STORAGE
31	C	STAIR
32	H	RESTROOM/ SHOWER
33	C	STAGE
34	C	KITCHEN
35	C	CAFETERIA
36	C	MECHANICAL
37	C	LOCKER ROOM
38	C	FREEZER/COOLER
39	C	CUSTODIAL
40	C	FACULTY USE
41	K	(LOCATION PER OWNER) SPRING CREEK ELEMENTARY

DESIGN WEST

LOGAN, UTAH
(435) 752-7031
SALT LAKE CITY, UTAH
(801) 539-8221

**SPRING CREEK ELEMENTARY
REMODEL & ADDITION**
350 W 100 N
PROVIDENCE, UT 84332
CACHE COUNTY SCHOOL DISTRICT

MARK	DATE	DESCRIPTION
1	02.19.2026	ADDENDUM 01



SCHEDULE -
SIGNAGE

A-681

© COPYRIGHT DESIGN WEST ARCHITECTS 2025

D

C

B

A

1

2

3

4

5

CONSTRUCTION DOCUMENTS

FINISH SCHEDULE

CARPET

MARK: C1	C2
TYPE: WALK-OFF (MAIN)	HYBRID (POWERBOND)
MANUFACTURER: SHAW	TARKETT
COLLECTION: STEPPIN OUT	GEOKNIT 10887
SERIES: WELCOME II TILE, 5T031	-
COLOR: CHARCOAL 31549	SATEEN 42715
PRODUCT SIZE: 24" X 24"	ROLL 6' WIDE
INSTALL PATTERN: QUARTER TURN	SEE FINISH PLANS
NOTES:	

RESILIENT FLOORING

MARK: RF1	RF2	RF3	RF4
TYPE: LVT (MAIN)	LVT (ACCENT 1)	LVT (ACCENT 2)	LVT (ACCENT 3)
MANUFACTURER: MANNINGTON	MANNINGTON	MANNINGTON	MANNINGTON
COLLECTION: COLOR ANCHOR	COLOR ANCHOR	COLOR ANCHOR	COLOR ANCHOR
SERIES: GROOVE	GROOVE	GROOVE	GROOVE
COLOR: COTTONTAIL (C118)	BIG WAVE (C150)	MIDNIGHT TWINKLE (C108)	VELVET (C148)
PRODUCT SIZE: 18" X 18"	12" X 24"	18" X 18"	18" X 18"
INSTALL PATTERN: SEE FINISH PLANS	SEE FINISH PLANS	SEE FINISH PLANS	SEE FINISH PLANS
NOTES:			

TILE

MARK: T1	T2	T3
MANUFACTURER: DAL TILE	DAL TILE	DAL TILE
COLLECTION: KEYSTONES	NATURAL HUES	COLOR WHEEL CLASSIC
SERIES: -	-	-
COLOR: D037 PEPPER WHITE	MATTE FRECKLES NH36	MATTE ELEMENTAL TAN 0766
PRODUCT SIZE: 2 X 2 MOSAIC	6" X 12"	3" X 6"
INSTALL PATTERN: MOSAIC	BRICK (HALF-BOND)	SEE INTERIOR ELEVATIONS
GROUT: MAPEI - 5011 SAHARA BEIGE	MAPEI - 5011 SAHARA BEIGE	MAPEI - 5011 SAHARA BEIGE
NOTES: RESTROOM FLOORS	RESTROOM WALLS (MAIN)	RESTROOM WALLS (ACCENT)

TRANSITIONS

MARK: TR1	TR2	TR3	TR4
TYPE: ALUMINUM FLOOR TRANSITION	ALUMINUM FLOOR TRANSITION	PVC FLOOR TRANSITION	ALUMINUM FLOOR TRANSITION
MANUFACTURER: POWERHOLD	POWERHOLD	TARKETT / JOHNSONITE	POWERHOLD
COLOR: MF	MF	63 BURNT UMBER	EA
MODEL: 402052 - LVT 124 2.5MM TO 4.5MM	LVT 129 - 2.5MM TO 7MM	S102903-63-CTAL	LVT 925 - 2.5MM SQUARE CAP
LOCATION: LVT TO TILE AND LVT TO EX. CARPET	LVT TO POWERBOND AND WALK-OFF CARPETS	WALK-OFF TO EXISTING CARPET	LVT TO EXISTING VCT
NOTES: LVT TO TILE TRANSITIONS MAY REQUIRE A SUBFLOOR LEVELER RAMP UNDER THE LVT		WHEELED TRAFFIC 3/8" TO 1/4"	

MARK: TR5	TR6	TR7	TR8
TYPE: ALUMINUM FLOOR TRANSITION	PVC FLOOR TRANSITION	RUBBER RAMP LEVELER	PVC FLOOR TRANSITION
MANUFACTURER: POWERHOLD	TARKETT / JOHNSONITE	ROPPE	TARKETT / JOHNSONITE
COLOR: EA	63 BURNT UMBER	-	63 BURNT UMBER
MODEL: 402022 - LVT 425 - 2.5MM BEVEL CAP	S102905-63-SLTA	SUBFLOOR LEVELER	WALK-OFF TO EXISTING VCT
LOCATION: LVT TO CONCRETE	CARPET TO EXISTING VCT	NEW CARPET AND LVT TO TILE	S102903-63-CTAK
NOTES:	SLIM LINE TRANSITION - 1/4" TO 1/8"		WHEELED TRAFFIC 3/8" TO 1/8"

MARK: TR9	TR10	TR11	TR12
TYPE: ALUMINUM FLOOR TRANSITION	ALUMINUM FLOOR TRANSITION	ALUMINUM FLOOR TRANSITION	ALUMINUM WALL TILE TRANSITION
MANUFACTURER: POWERHOLD	SCHLUTER SYSTEMS	POWERHOLD	SCHLUTER SYSTEMS
COLOR: MF	SATIN ANODOZED	EA	SATIN ANODOZED
MODEL: 402079 - LVT 123 - 2.5MM TO 3.5MM	RENO-TK REDUCER 1/2" AETK125	402062 - LVT 908 - 8MM SQUARE CAP	QUADEC - 08MM - 080AE
LOCATION: LVT TO EX. VCT	TILE TO EX. VCT	WALK-OFF TO CARPET	TILE TO TILE - OUTSIDE WALL CORNER
NOTES:			

WINDOW COVERINGS

MARK: WC1
TYPE: MANUAL ROLLER SHADE
MANUFACTURER: MECO
SIZE: VERIFY WINDOW SIZE IN FIELD
COLOR: ECOVEL 5% OPEN, BLACK/BROWN 1354
NOTES: PHASE 2 - PRINCIPAL AND RECEPTION

MISCELLANEOUS

MARK: MI1
TYPE: ALUMINUM CORNER GUARD
MANUFACTURER: INPRO
MODEL: DW-AL03412-CLR
COLOR: CLEAR
PRODUCT SIZE: 3/4" WINGS
INSTALL PATTERN: -
NOTES: INSTALL UP TO 6'-0" AFF

FINISH COMBINATIONS

FLOOR COMBINATIONS

MARK: 3A	3B	3C
LOCATION: ANNEX CORRIDORS	BREAKROOM	RECEPTION & OFFICE CORRIDOR
DESCRIPTION: RF1 AS MAIN LVT W/ RF2 ON PERIMETER OF CORRIDORS W/ RF3 AND RF4 TILES INTERMINGLED THROUGHOUT. SEE FINISH PLANS	C2 AS MAIN CARPET W/ RF1 IN PREP AREA OF ROOM AND CLOSET.	LVT AT ENTRY AND DOWN CORRIDOR BETWEEN DESK AREA COMPRISED OF RF1 AS MAIN LVT W/ RF2 ON PERIMETER OF CORRIDOR W/ RF3 AND RF4 TILES INTERMINGLED THROUGHOUT. C2 AS MAIN CARPET IN DESK AREAS. SEE FINISH PLANS.

MARK: 3D
LOCATION: BREEZEWAY
DESCRIPTION: COMBO OF C1 AND C2. SEE FINISH PLAN FOR LAYOUT.

CEILING COMBINATIONS

MARK: 1A
LOCATION: RECEPTION, PRINCIPAL, HEALTH AIDE, AND PANTRY
DESCRIPTION: CL2 W/ GYP SOFFITS AND GYP CEILINGS PAINTED W/ P1

WALL COMBINATIONS

MARK: 2A
LOCATION: FACULTY RESTROOMS
DESCRIPTION: T2 FROM FLOOR UP TO 4'-8"; BAND OF T3, BAND OF T2, BAND OF T3, T2 FROM 5'-8" UP TO CEILING

MILLWORK FINISHES

MARK: MF1
TYPE: HIGH PRESSURE LAMINATE
MANUFACTURER: WILSONART
COLOR: DAINTREE 8239K-05
FINISH: TIMBERGRAIN
NOTES: GRAIN TO ALWAYS RUN VERTICALLY

MILLWORK HARDWARE

MARK: MH1
MANUFACTURER: -
COLOR: BLACK
STYLE: WIRE PULL
SIZE: 4" CENTER TO CENTER
NOTES: -

COUNTERTOPS

MARK: CT1	CT2	CT3
TYPE: HIGH PRESSURE LAMINATE	HIGH PRESSURE LAMINATE	SOLID SURFACE
MANUFACTURER: WILSONART	WILSONART	WILSONART
COLOR: ORGANIC COTTON 4945-38	NAVY LEGACY 4651-60	OATMEAL 9101GS
FINISH: FINE VELVET	MATTE	-
NOTES: RECEPTION DESKS	CLASSROOM & LOCKER COUNTER	CLASSROOM WINDOW SILL - 1/2" THICK MATERIAL

CEILING

MARK: CL1	CL2	CL3
TYPE: VINYL WRAPPED ACT	ACT	ACT
MANUFACTURER: -	ARMSTRONG	ARMSTRONG
MODEL: -	CALLA	CALLA
SIZE: 2' X 2'	2' X 2'	2' X 4'
COLOR: MATCH EXISTING	WHITE	WHITE
NOTES: RESTROOMS IN LOCKER ROOMS	OFFICES IN LOCKER ROOMS, ANNEX CORRIDOR	ANNEX CLASSROOM

PAINT

MARK: P1	P2
MANUFACTURER: SHERWIN WILLIAMS	SHERWIN WILLIAMS
COLOR: PEARLY WHITE SW 7009	BY ARCHITECT
SHEEN: SATIN	SATIN
NOTES: MAIN COLOR	MURAL COVERUP

EPOXY PAINT

MARK: EP1
MANUFACTURER: SHERWIN WILLIAMS
COLOR: PEARLY WHITE SW 7009
SHEEN: SATIN
NOTES: RESTROOMS


BASE

MARK: B1	B2
TYPE: RUBBER	TILE COVE BASE
MANUFACTURER: ROPPE	DAL TILE
COLOR: 183 BLACK BROWN	MATTE FRECKLES NH36
SIZE: 4" H	6" X 12"
STYLE: 700 SERIES W/ STANDARD TOE	NATURAL HUES - P36C9
NOTES: -	RESTROOMS - MATCH T2 GROUT

GENERAL NOTES

- ROOM FINISH TAGS FOR EACH ROOM REPRESENT TYPICAL FINISHES. SPECIFIC WALLS IN SELECTED AREAS MAY HAVE MULTIPLE FINISHES WHICH WILL BE INDICATED IN INTERIOR ELEVATIONS.
- FIELD VERIFY ALL DIMENSIONS PRIOR TO FABRICATION OF CASEWORK AND FINISH ASSEMBLIES
- SEE INTERIOR ELEVATIONS FOR ADDITIONAL FINISH INFORMATION
- SEE REFLECTED CEILING PLANS FOR ADDITIONAL FINISH INFORMATION
- FOR FINISH SCHEDULE SEE SHEET A-691
- FLOOR MATERIAL TRANSITIONS WILL OCCUR BELOW DOORS U.N.O. SEE DETAIL D3 (A-593)
- FOR TYPICAL TRANSITION/FINISH DETAILS SEE SHEET A-593
- SEE SHEET A-681 FOR SIGNAGE TYPES AND DESCRIPTIONS
- TILED WALLS TO BE FULL HEIGHT OF WALL, U.N.O.
- FLOOR COVERING DOES NOT EXTEND UNDER MILLWORK OR CASEWORK, U.N.O.
- INSTALL FLOOR TILE EXPANSION JOINTS AS PER TCNA.
- ALL EXPOSED STRUCTURE TO BE PAINTED U.N.O.

LEGEND

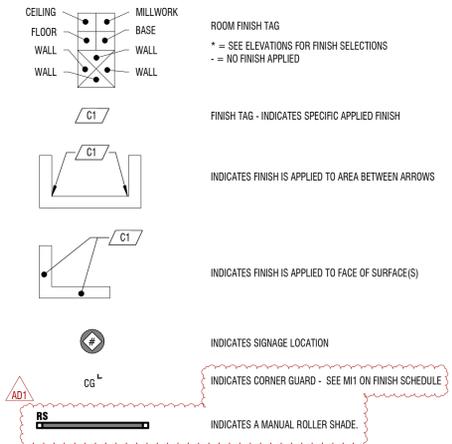

MARK:	DESCRIPTION:	ADDITION 01
DATE:	02.19.2026	
PROJECT #:	123008	
DRAWN BY:	WK	
CHECKED BY:	MR	
ISSUED:	02.19.2026	



CONSTRUCTION DOCUMENTS



Nielson Engineering, Inc.

An Innovative Engineering Firm
Consulting Engineers
Electrical · Mechanical
Information Systems · Petroleum

Plumbing Addendum 1

3-2-26

Plumbing Fixture Schedule

1. Delete P7 water cooler from the schedule.
2. Fixtures FS-1 & FD-2 fixtures are shown on plan PR2-111 as part of the Remodel Phase 2.
3. The water hammer arrestors (WHA) shall be located at the end of each hot and cold water branches in Restroom A102E, Breakroom 1 for P4 & P5 fixtures and in Restroom 3B at the hot water supply for fixture P3.

(Plumbing Specification)

Section 221116 Domestic Water Piping

1. Contractor shall use copper piping for all domestic water piping.
2. Delete all references to PEX piping. PEX piping is not approved.

Section 221316 Sanitary Waste & Vent Piping

1. All PVC/ABS DWV piping shall not be insulated.
2. PVC/ABS roof drain piping shall be insulated.

